a = Stone N.E. ∠ Sec. 32. B.O. stump east 33 links

b = Stone NW ∠ " "

C = Stone ¼ Sec. ∠ W.O. 30" S74½W 7½ lks. Elm 30" N18 64 lks.

d = Stake middle of line C.E. ¼ Sec. ∠

e = Post middle line a.f. ¼ Sec. ∠ bring 6½ lks N of fence row cent.

f = Stake 1' south of cent gravl on pike. W.O. 24" S27½W 52' = 79 lks.
also telephone pole N73¾E 48 lks ℄ cent bridge S.31W — — — —

g = Stake mid. line f.h. = ¼ Sec ∠. B.O. 20" (forked 4" from ground) S56¾W 20 lks.
and W.O. 18" N25½W 34¾ lks.

h = stone cent road, S.W. of sec. Wild Cherry 18" N12¾E 32½ lks.

i = stake, stone to be plantrd ∠ to Smith and Huber. N2¾E 24p. from h.

j " " " " " " " " " " N2¾E 24p " g

INDEXED ON MAP
969 ID

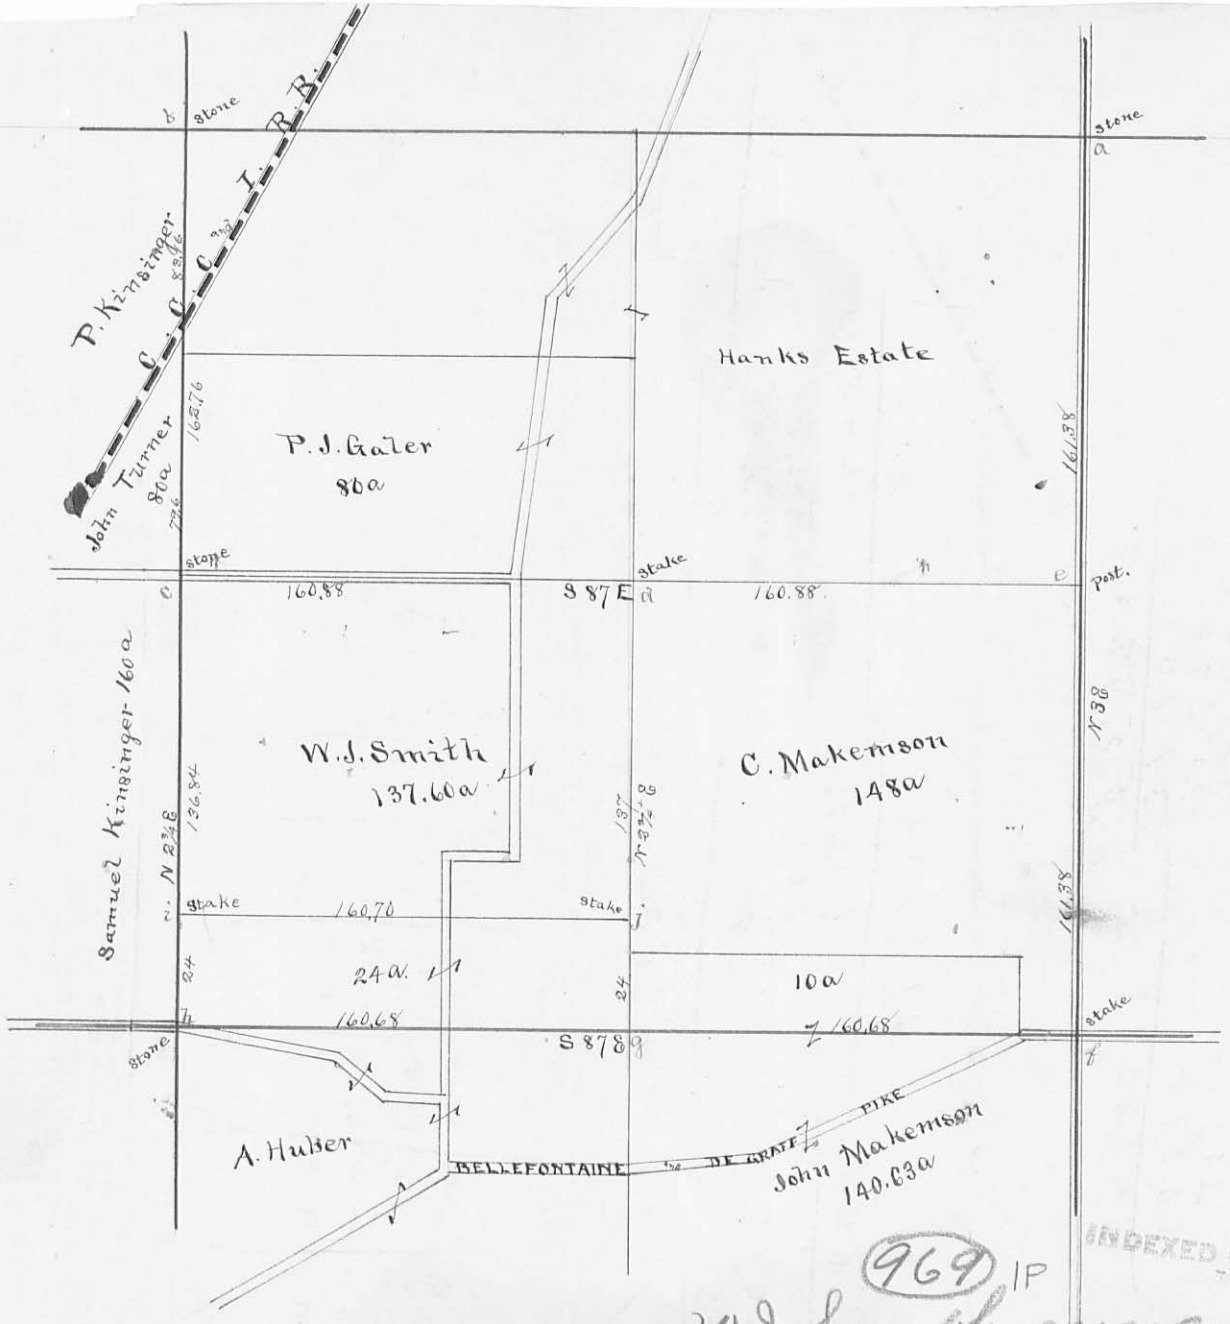

969 IP

INDEXED ON MAP

W J Smith survey
Pleasant Twp
Sec 32 T 2 R 14