Road #208
Pleasant Twp

	Sept 3–20
J.S. Crane	1
Ross Antrim	1
Ivan Wickersham	1
Lunches	1.50

1342
INDEXED ON MAP

Road #208
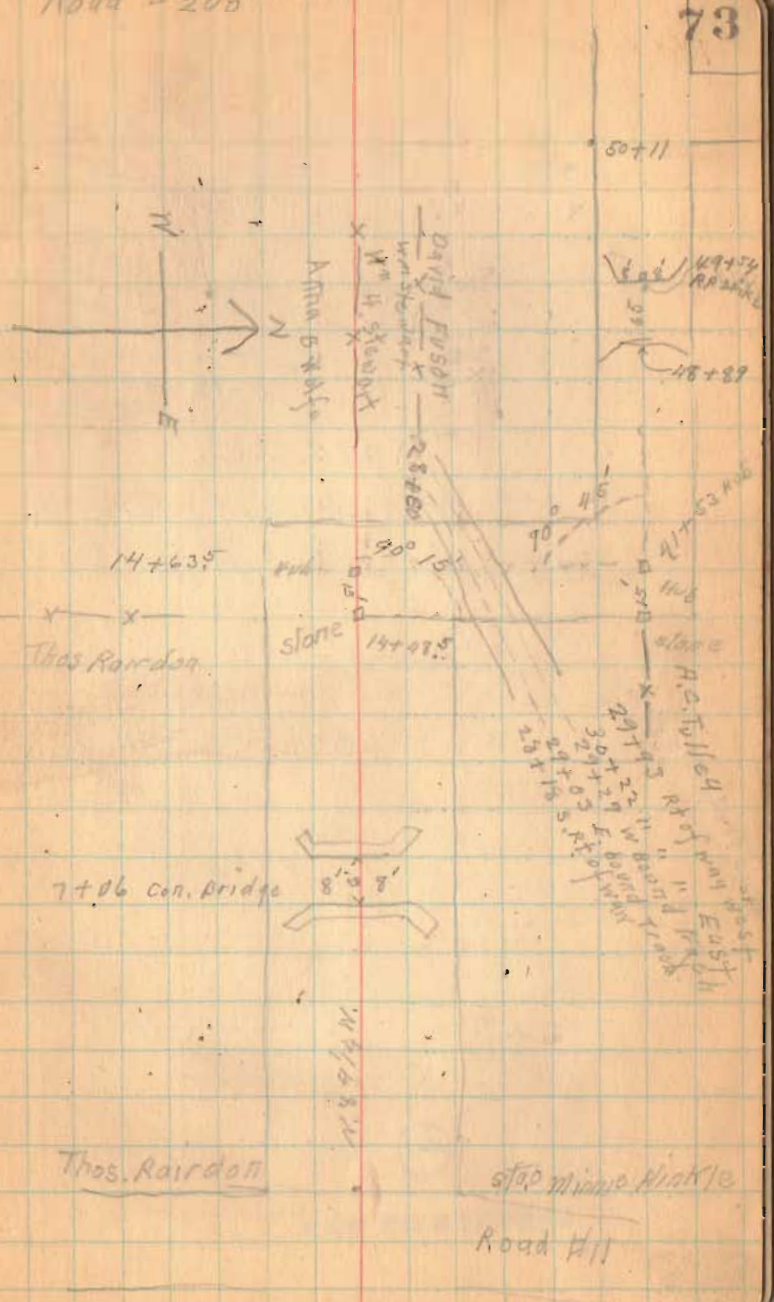
73