No. 240. N W corner S. S89½ E Beech 10 Ds S67W 12 do 10 " N73 16 Links N E corner

S22. T3. R13 W. R.

(8327)

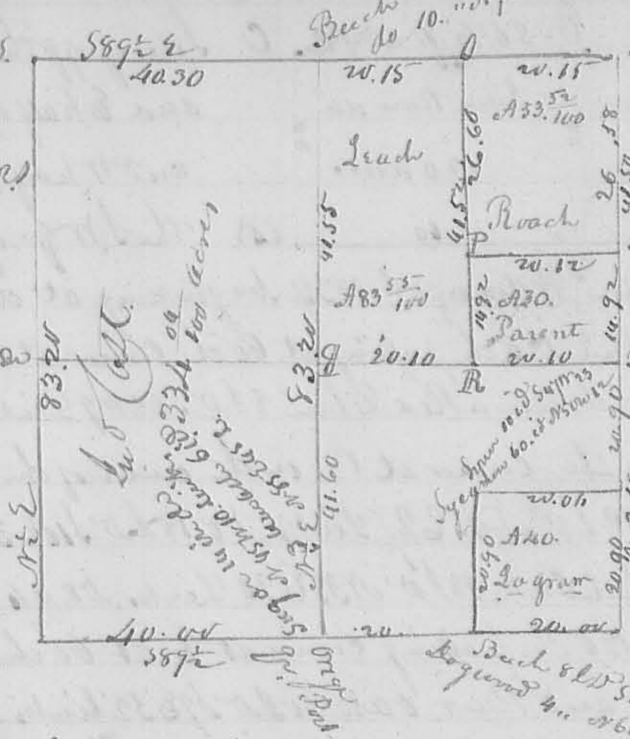

Hickory 15 Ds N77W 15 links
Beech 10. N61W 21 do

no corner made

Beech 8 Ds S32 E 5 links
do 10 " N28W 8. orig. of corn

Beech 18 Ds North 12 D.
Gray Ash 22 West 40.

Beech 14 Ds corner tree

Beech 8 Ds S60W 16
Dogwood 4 " N60E 41

Corner at "O" White Ash 6 Ds S64½ E 45 links
" at P Beech 12 Ds N48W 4½ Links Sugar 18 Ds S84E 5 Links –
" " Q Poplar 24 Ds N64W 33 links
" " R Ash. 6 Ds S32½ W 5 Links. Elm 18 Ds N32½ E 19 links

John Coplin }
Wm Parent } Ch. men Apl. 18. 1834

L. Hopkins dep. Sur. L.

No. 241

(8325)

S15. T1. R8 E

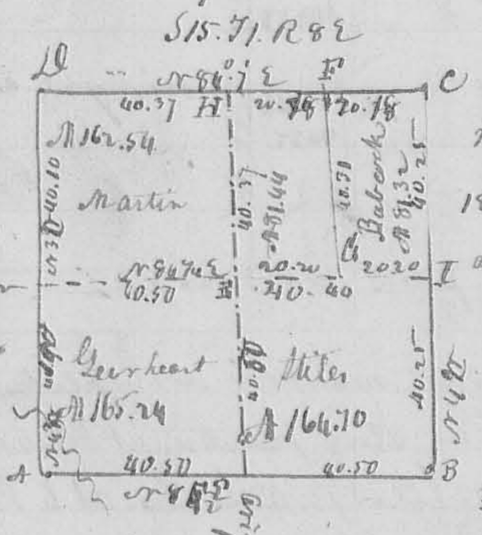

Orig. corner

Orig. corner

Description of corners not marked on the plat. At I Beech 18 Ds East 50 links. Elm 18 " N78 E
at F blue Ash 4 Ds S50 E 20 links –
do. 18 Ds N44W 24 links. –
G Beech 08 Ds N10 E 17½ links
Ironwood 6 Ds S22W 19 Links
E. Hickory 18 Ds S66W 29 W. Ash 4 Inches N23½ E 9 Links –
at H Gray Ash 10. Ds N76½ W 13½ Links
do 20 Ds. S43½ E. 33½ Links –

May. 1834
John G. Gearheart }
Asahel Martin } Ch. Car.

L. Hopkins. dep. Sur. L.