Survey For Standard Oil Co.

Quincy O. 10/7/13 Sec 13 T 3 R 10.
Pt W½ of N.W.Q.

R.R. McClure ch
J.S. Knoop ch

Cash paid Helps = 4.00
Livery, Feed & B = 12.60

G.W. Hoover, J.S. Knoop & Mr Eichar
Say line AB. is south line of Mill St

Could find no stone or pins at
any corner or strut +.

Considered "AB" as S. - of Mill St.

Produced "AB" to "H." as Mill & Carlisle

Took old fence line "HE" as E. - of Carlisle

"BC" = Old Fence Line.
"DC" = " "
"DE" = " "

D.T.&I. Agent says "AE" is E. Right-of-Way Ry.

Set stake at "H." & "A"

C.C.C.&St.L.R.R.

K = ⊙ Main Track
M = " "

K & M are 33' from A & E Respect.

∠ BAC = 40° 0'
∠ BAD = 56° 0'
∠ HGF = 90° 39'

HG = N 5 E = 276.2'
HB = 280.5'
AB = S 85½ E 150.5'
BC = S 5 W 127'
DC = N 85½ W 65'
DE = S 15½ W 21.8'
AE = 172.7 (with curve)
(D) D' = 14' (D) E = 23'
HA = 91.5'
R. of W. RR = 66'

5 14 = G to X
"X" = Prop. Line Point of C.C.C.&St.L. R.R.

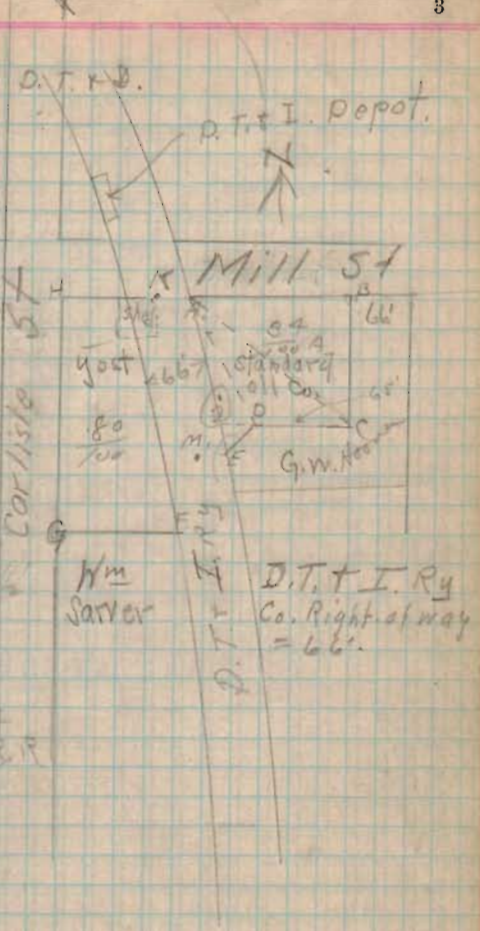

780

INDEXED ON MAP

4/24/14

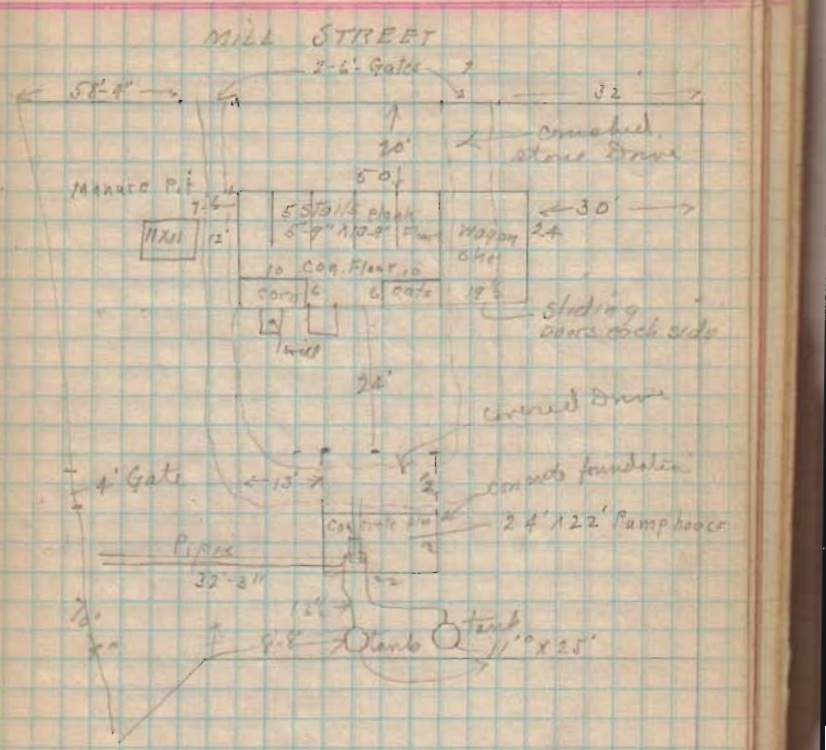
MILL STREET
2-6' Gate
58'-4"
32'
20'
Concrete Stone Drive
Manure Pit
7.6
5'0"
5 Stall plank 6'-9" x 10-9"
Wagon 24
30'
11x11
12'
10 Con. Floor 10
Corn 6
6 Oats
18'6"
Sliding Doors each side
Well
24'
Curved Drive
4' Gate
13'
concrete foundation
Concrete floor
24'x22' Pump house
Pipes
32'-2"
12'6"
9'-8"
Tanks
tank
11'0"x25'