KIRK SURVEY RICHLAND TWP. SURVEY

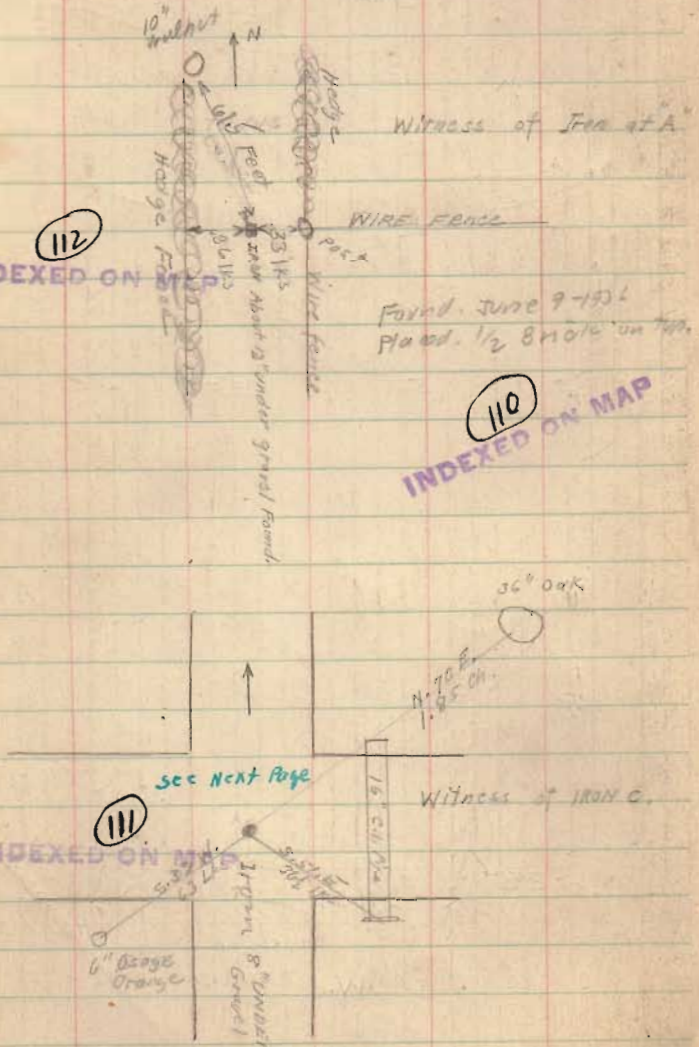

Oct. 2, 1924
Wright
Mr. Kirk
Mr. Kuhle (Lawyer)
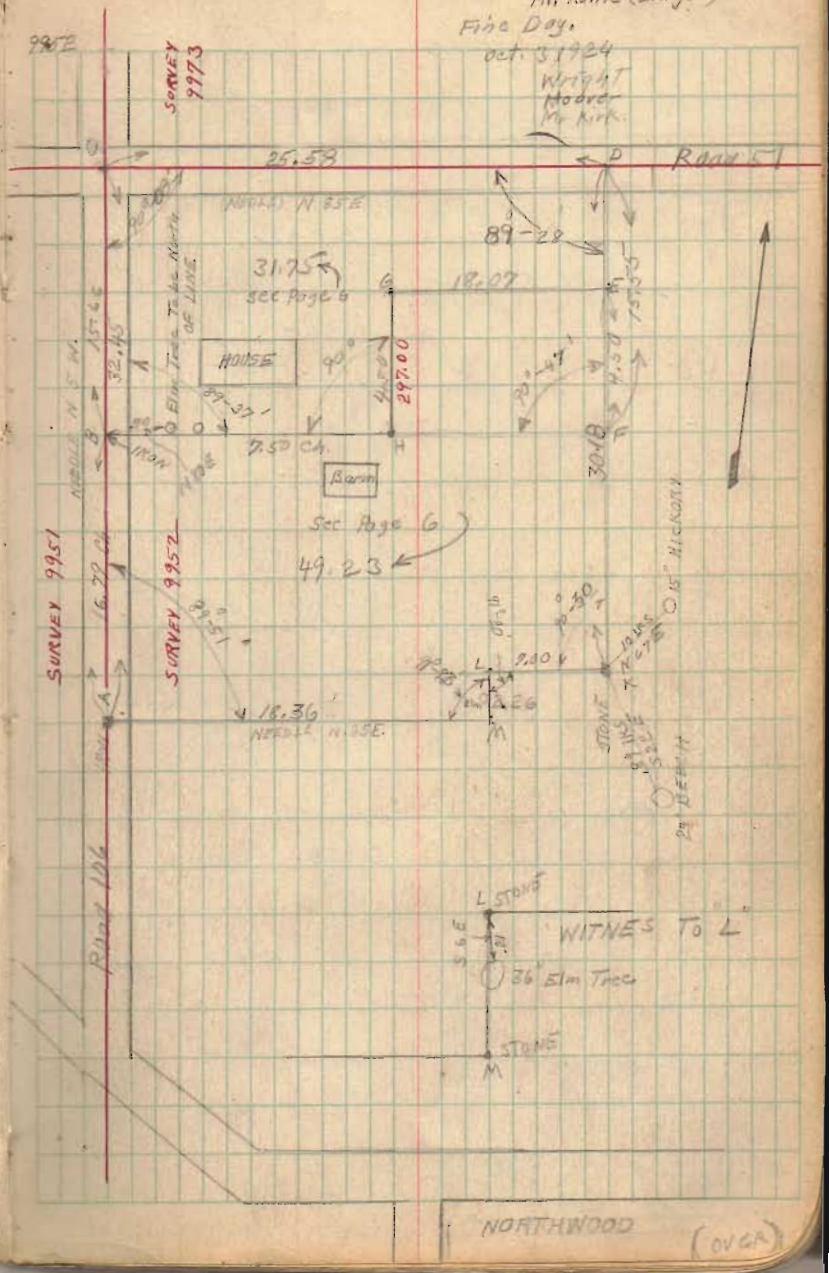
Fine Day.
Oct. 3 1924
Wright
Moore
Mr. Kirk.