

Received 11-14-86

OK (C.P.)

**LESLIE H. GEESLIN**  
REGISTERED SURVEYOR NO. 5248  
P. O. BOX 274  
RUSHSVLVANIA, OHIO 43347

TELEPHONE: (513) 468-2793

WINGFIELD SURVEY

November, 1986

The following described real estate situated in the State of Ohio, County of Logan, Township of Bokescreek, being part of outlot 52 in Virginia Military survey 10239 in the Village of Ridgeway and more particularly described as follows:


Beginning at a railroad spike in the intersection of the centerline of East Street and Township Road 121 at the southwest corner of outlot 52.

Thence with the center of said East Street N.  $11^{\circ} 34'$  W. 173.88 feet to a railroad spike. The bearings of this description are based on the bearing of T. R. 121 which is taken from a July, 1983 survey of a 317.15 acre tract by Daniel Gilbert and all other bearings are from angles turned in this field survey.

Thence N.  $78^{\circ} 00'$  E. 202.46 feet to a 0.625 inch iron bar, passing a 0.625 inch iron bar at 25.00 feet.

Thence S.  $11^{\circ} 34'$  E. 173.88 feet to a railroad spike in the centerline of said T. R. 121, passing a 0.625 inch iron bar at 153.88 feet.

Thence with said centerline S.  $78^{\circ} 00'$  W. 202.46 feet to the place of beginning.

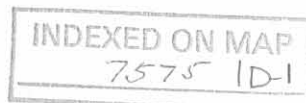

Containing 0.808 acre more or less.

The above 0.808 acre tract being in the southwest corner of Billie Wingfield's O. L. 52 as described in O. R. Vol. 30, Page 881.



*Leslie H. Geeslin*  
LESLIE H. GEESLIN  
RUSHsylvania, OHIO

INDEXED ON MAP  
7575 ID2

33 00'  
3/4 BAR  
FD.

N

A 25 B

N. 78° 00' E. 202.46'

B

EAST STREET (66')  
N. 11° 34' W. 173.88'

0.308 AC.

S. 11° 34' E. 173.88'

S. 78° 00' N. 202.46'

TOWNSHIP ROAD 121

20 B

RR SPIKE FO.

S.R. 292

3/4 BAR  
FD.

SURVEY OF 0.308 AC. TRACT  
IN S.W. CORNER OF OUTLOT 52 IN  
VILLAGE OF RIDGEWAY, V.M.S. 10239,  
BORES CREEK TWP., LOGAN COUNTY,  
OHIO FOR BILLIE MANSFIELD.

NOVEMBER 1986  
SCALE: 1" = 40'

LEGEND:

A = RR SPIKE SET  
B = 3/8" IRON BAR SET

INDEXED ON MAP  
7575 IP



Leslie H. Geeslin  
LESLIE H. GEESLIN  
RUSHSVLVANIA, OHIO