

Received 8-26-88

OK 8-29-88 C.R
MAP ROOM

SPONSLEER TO TROYER SURVEY

The following described real estate situated in the Township of Taylor Creek, County of Hardin and the Township of Rushcreek, County of Logan, State of Ohio and being a part of Virginia Military Survey No. 13079 and being a part of a 67.50 Acre tract in the name of P. Bernard Sponsler, recorded as Tract No. 3 in Volume No. 57 Page 148 (Hardin County) and Volume 348 Page 105-107 (Logan County) (6-29-1973) and being more particularly described as follows:

Beginning at a wood corner post at the southwest corner to said 67.50 Acre tract and in the south line of V. M. S. No. 13079 and being in Rushcreek Township, Logan County, Ohio;

Thence with the west line of said 67.50 Acre tract, N. 8°51'29" W. 966.95 feet to the center of a creek, passing through the line between Logan and Hardin Counties at 165.00 feet and a 5/8" x 30" Rebar set at 951.95 feet near a steel fence post found;

Thence with the center of said creek, N. 89°32' 55" E. 950.39 feet to a 5/8" x 30" Rebar set, leaving the center of said creek at 830.39 feet;


Thence with the east line of said 67.50 Acre tract, S. 5°53'51" E. 679.32 feet to a point in the south line of V. M. S. No. 13079 and being the southeast corner to said 67.50 Acre tract, (Note: The last 539.32 feet of said line is in the center of a creek);

Thence with the south line of V. M. S. No. 13079 and the south line to said 67.50 Acre tract, S. 71°45' W. (Basis of Bearing) 917.40 feet to the place of beginning, passing through a 5/8" Rebar found at 12.21 feet and the line between Hardin and Logan Counties at 417.90 feet, containing a total of 758,951.085 square feet or 17.423 Acres, more or less.

Of the above described tract, there is 16.591 Acres in Taylor Creek Township, Hardin County and 0.832 Acres in Rushcreek Township, Logan County, Ohio.

I hereby certify that this is a true and accurate survey made by me on August 22, 1988 and is based on a field survey.

INDEXED ON MAP
552 1D

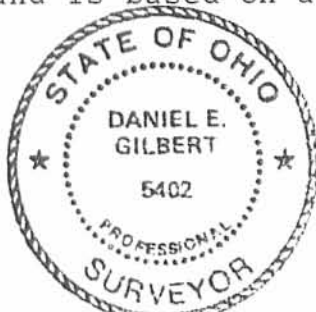

Daniel E. Gilbert
DANIEL E. GILBERT, P.S.
Reg. Sur. No. 5402

P. Bernard Sponsler
 Hardin County Vol. 57 P. 148 (6-29-1973)
 Logan County Vol. 348 P. 105-107

Tract No. 3 - 67.50 Acres

Total - 758,951.085^{sq}
 or 17.423 Acres

16.591 Acres (Hardin Co.)

Robert T. Troyer et ux

HARDIN
 LOGAN

COUNTY
 COUNTY

Per. Prr. No. 40-010-00-00-001
 0.832 Acres
 (Logan Co.)


Taylor Creek Township
 Rushcreek Township

Robert T. Troyer et al

V. M. S. No.
 V. M. S. No.

Wood
 Cor. Post

• -5/8" Rebar found.
 o -5/8" x 30" Rebars set.

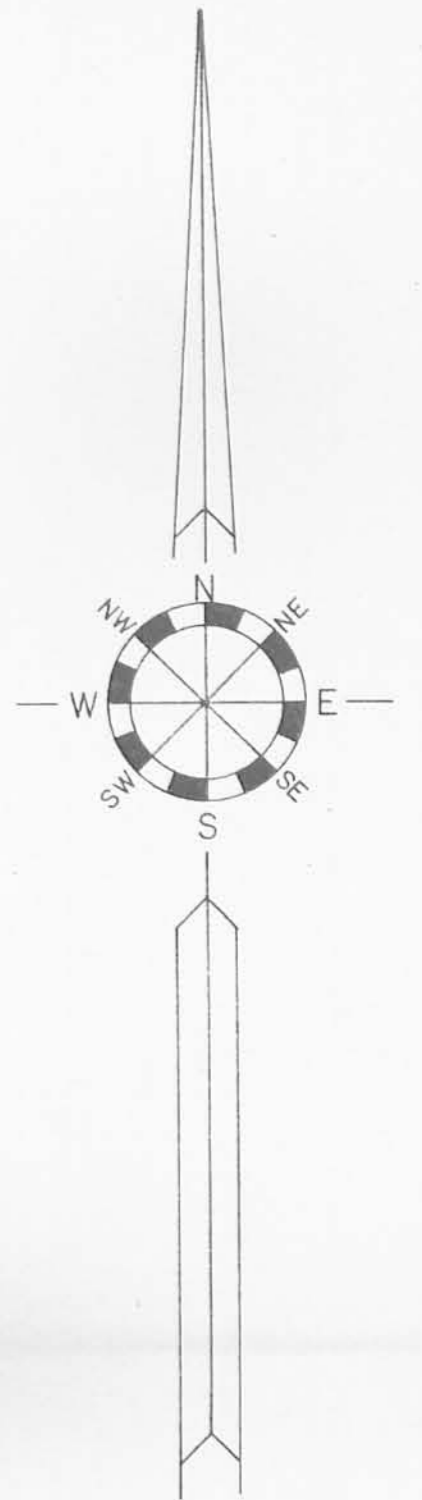

Sponsler to Troyer Survey - V.M.S. No. 13079 Taylor Creek Township, Hardin County, Ohio. Rushcreek Township, Logan County, Ohio.	
SCALE 1" = 100'	DATE 8-22-1988
DRAWN BY DEG	REVISED
<i>Daniel E. Gilbert</i> Daniel E. Gilbert, P.S. Reg. Sur. No. 5402	
DRAWING NUMBER 088-061	

INDEXED ON MAP
 552 IP

INDEXED ON MAP
 552-1P