Road. 110
Rushcreek Twp.
V. M.S. 10041

60' Road. Comm. Journal
No. 4 Page 82-84
June 1834

Stakes placed for 50'

(1624)

INDEXED ON MAP

Dec. 4, 1934
Cold Wind
F. Wright
E. A. C.
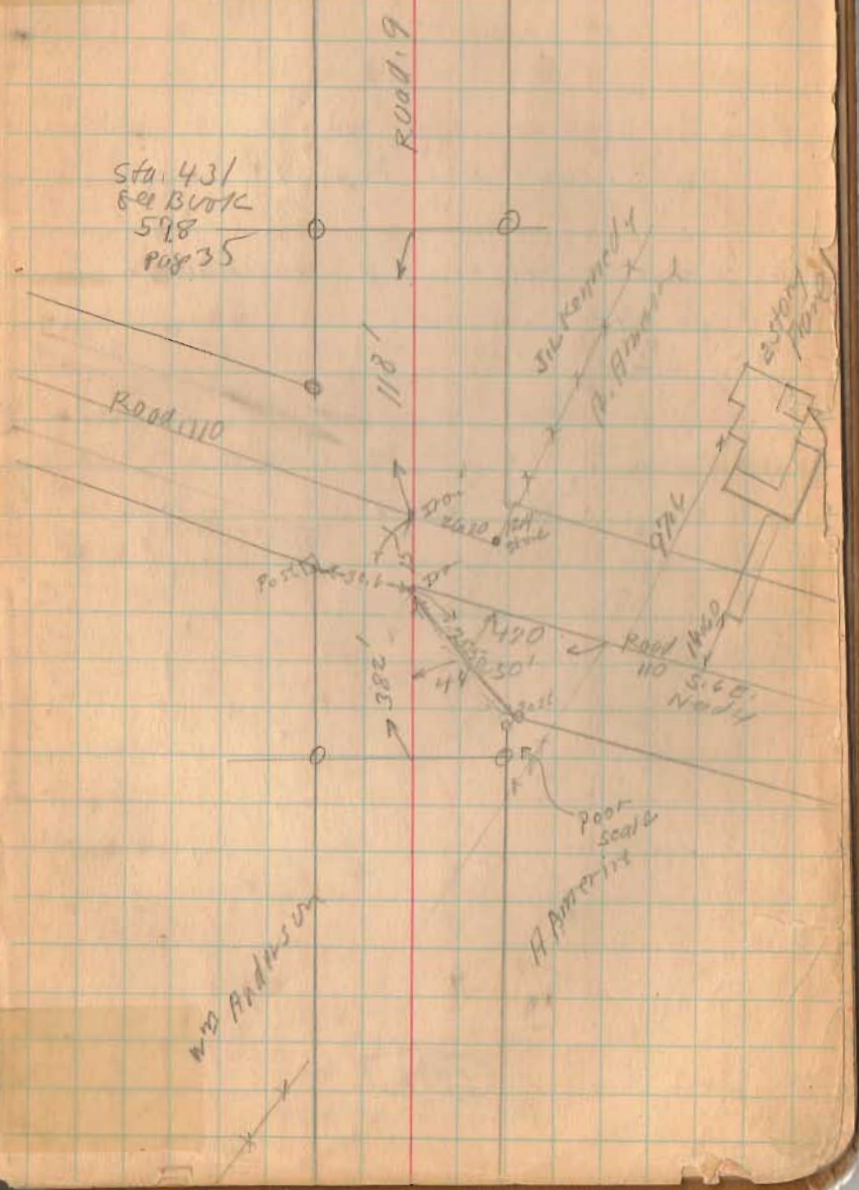
71