

Pennsylvania Streets
Stewart Street

Δ - RR spikes

Stewart Street 52.62' wide

All alleys and lot

lines 90° to Stewart St

56

188

181

4+50 Marquette

4+52.5

4+45.0 Alley (15')

4+37.5

4+40

180

4+00

179

3+37.5

3+30.0 Alley (15')

3+22.5

3+00 178

177

2+22.5

2+15.0 Alley (15')

2+07.5

2+00 176

175

1+07.5


1+00 1+02.5 Alley (10')

1+97.5

M.R. Church

4405

INDEXED ON MAP

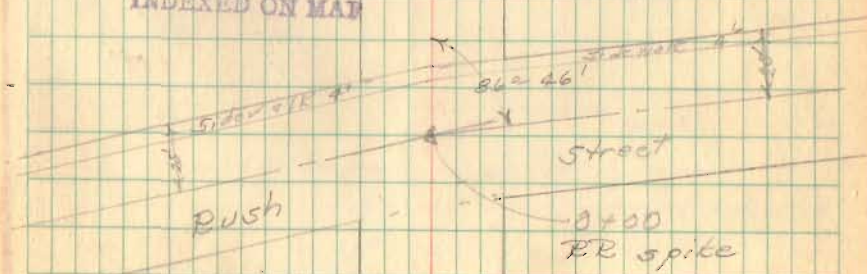

Stewart St. (contd)

