G. Wilgus
R. Phillips

Road #5

0+0 Beginning at Road 20

Stakes set every 200'
1-3-5-7-9 8

Mon Hubs

19+00

11+00

5+00

1+0

Hubs reset (6 July 76 CEK)

4425

INDEXED ON MAP

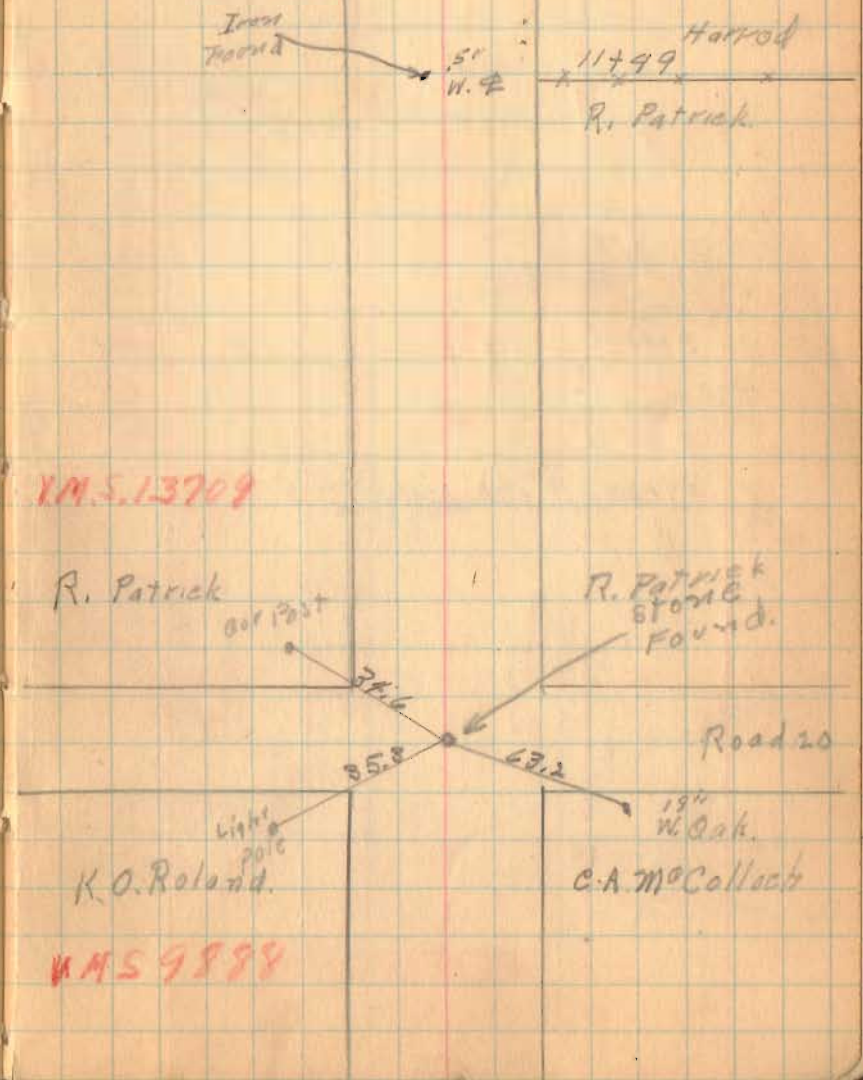

Mont. Hubset

31+00

27+00 Right only

H.A. Shoemaker
32+84
C.A. McCollock

H.A. shoemaker
31+37
C.A. McCollock

Iron set

16 house
23.5
27+00

VMS 12536

Iron Found

C.A. McCollock
R. Patriela

C.A. McCollock
22+982
F. Harrod

VMS 13708

Mont Hubs

51+00

45+00

41+00

36+36.4 Hub set at 30.01'

John Kinney 51+10

H Miller

John Kinney

H A Shoemaker

H Miller

46+50

H A Shoemaker

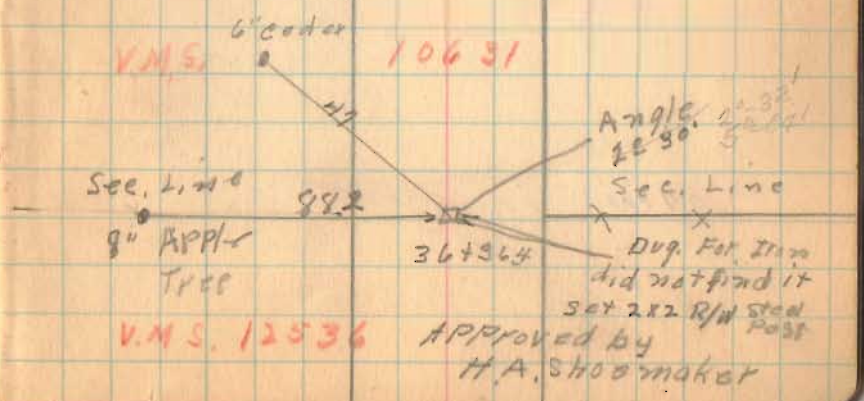

Mark Hubs

64+00

69+00

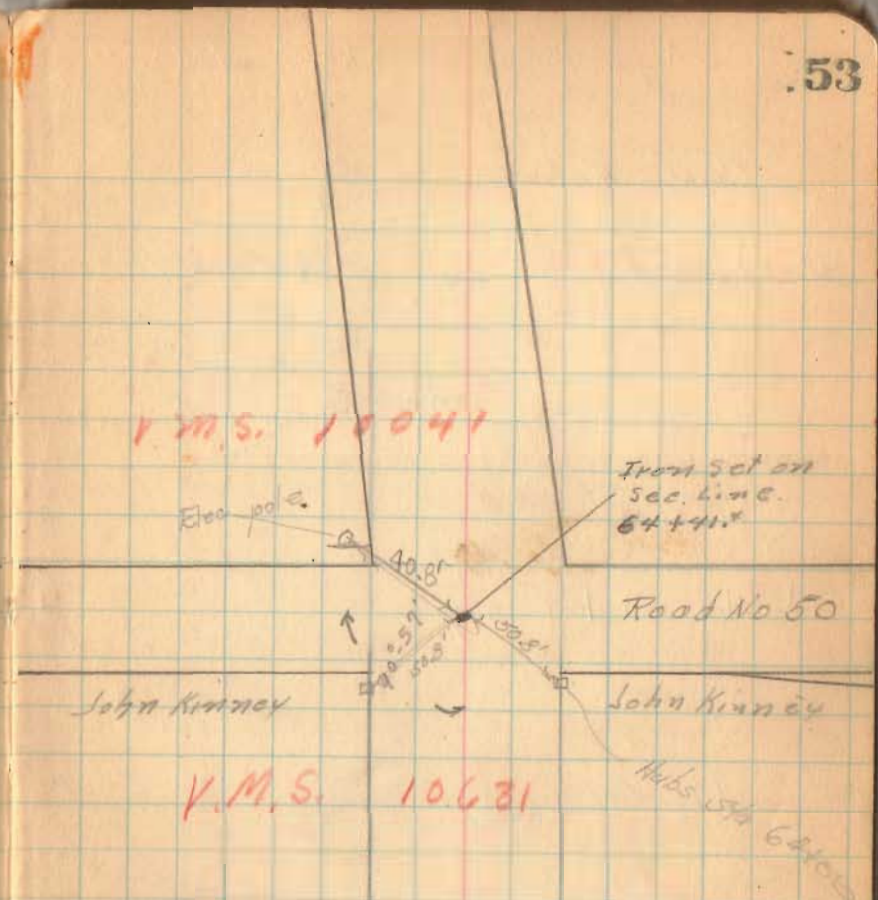

Monuments checked (CEK 27 July 46)

County Highway No. 5

Continued from Book 588 Page 70.

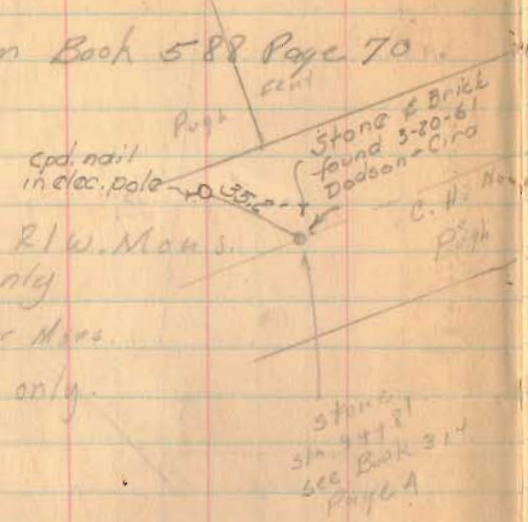

88+50 Hubs Set for R/W. Mons.
Mon left only

85+00 Hubs Set for Mons.
Mon on left only.

Stone
Sta. 941.8'
See Book 31
Page 4

80+00 Hubs Set for Monuments

Sta. 75+00 Hubs Set for Monuments.

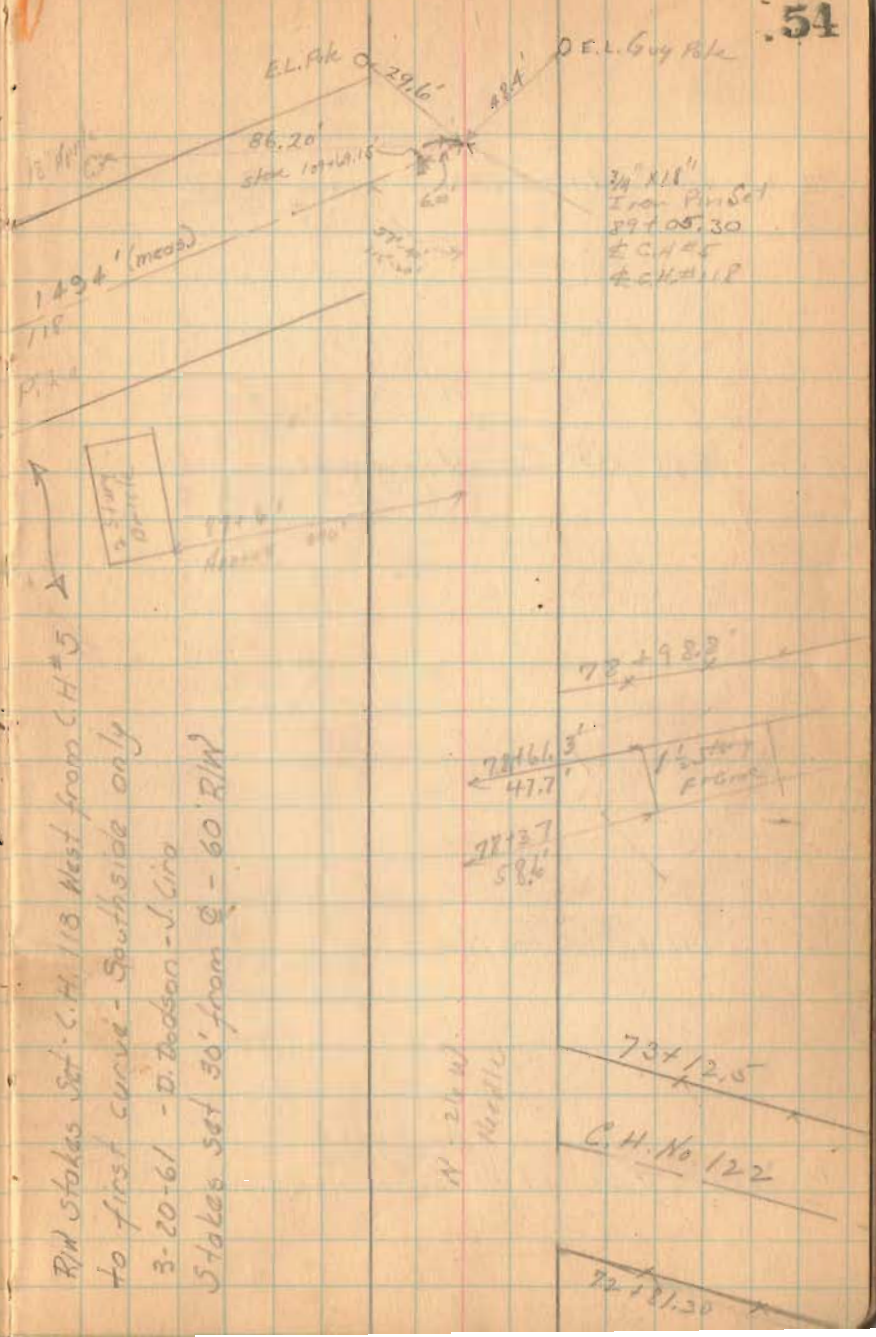

101+39.70 Hubs Set for Mons. 9° 53'-40" 43 4-56'-50"

99+50 Hubs Set for Monuments.

94+00 - Hubs Set for Mons.

sta. 89+50 Hubs Set for Monuments.

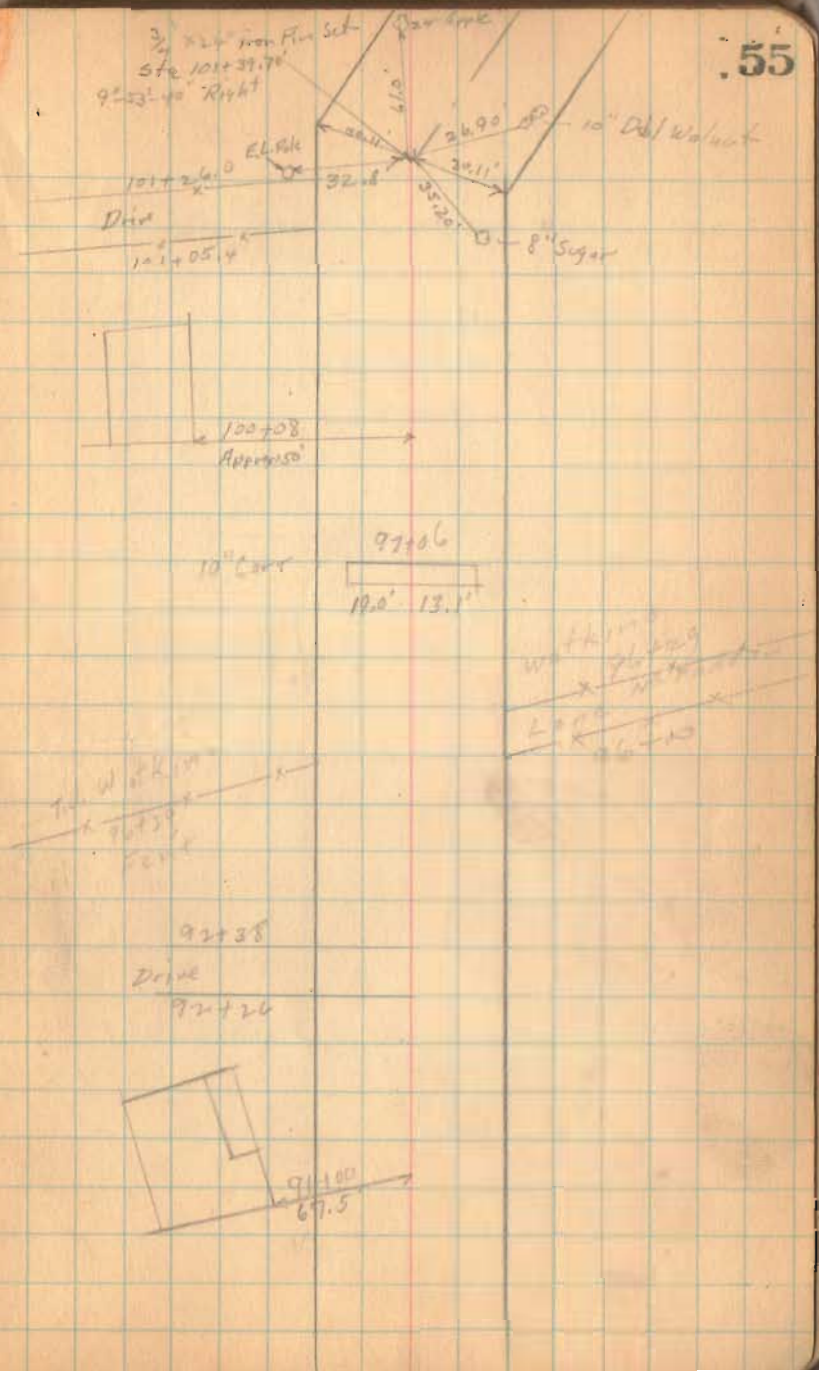

39.10
6.80

112 + 00 set Hub for Monument

107 + 00 Hub set for Monument

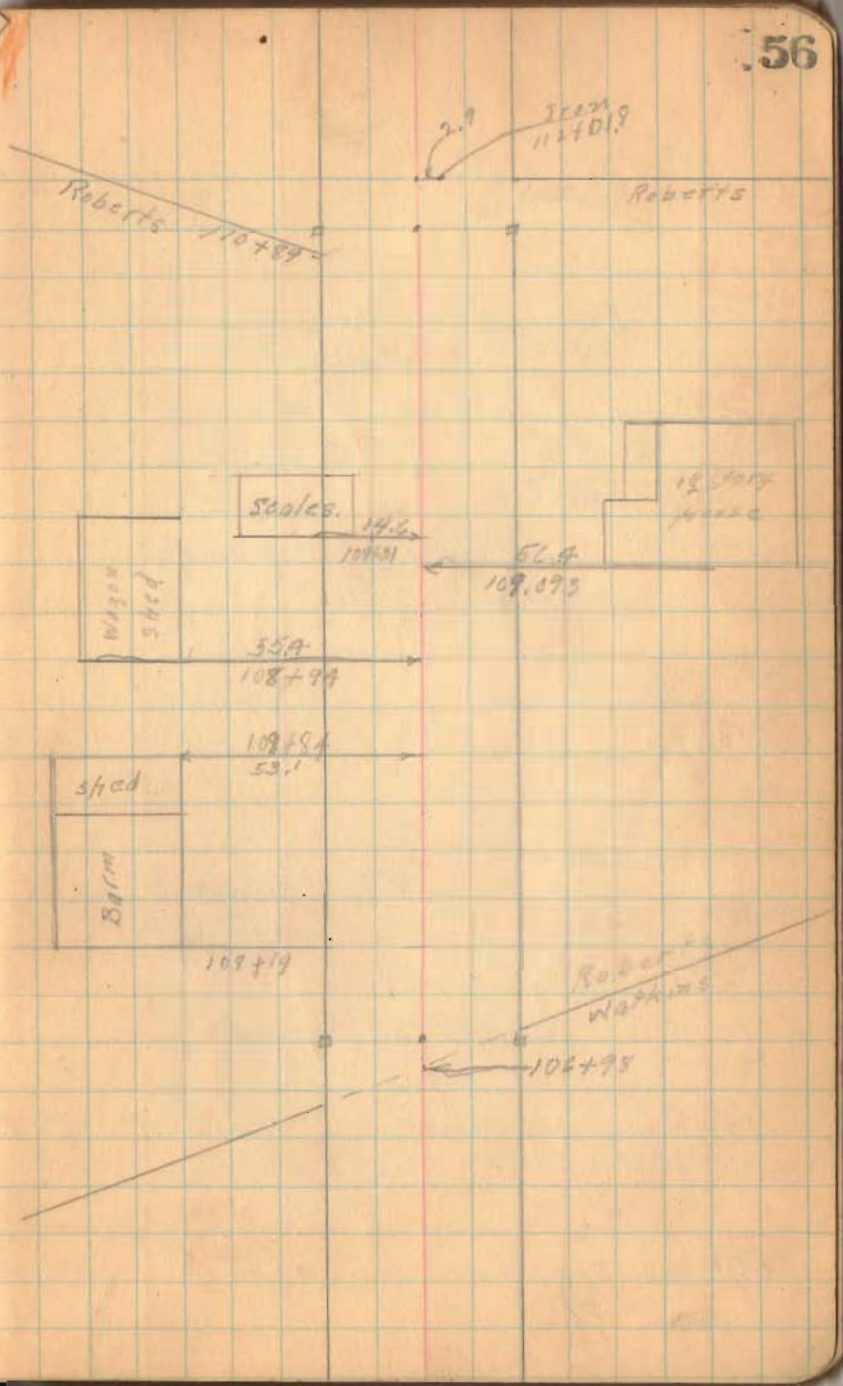

(122+52.3)

~~120+61.3~~ set Hubs for Monuments

(120+00)

(118+00) set Hub for Monuments.

116+00 set Stakes

114+00 set stake for fence line

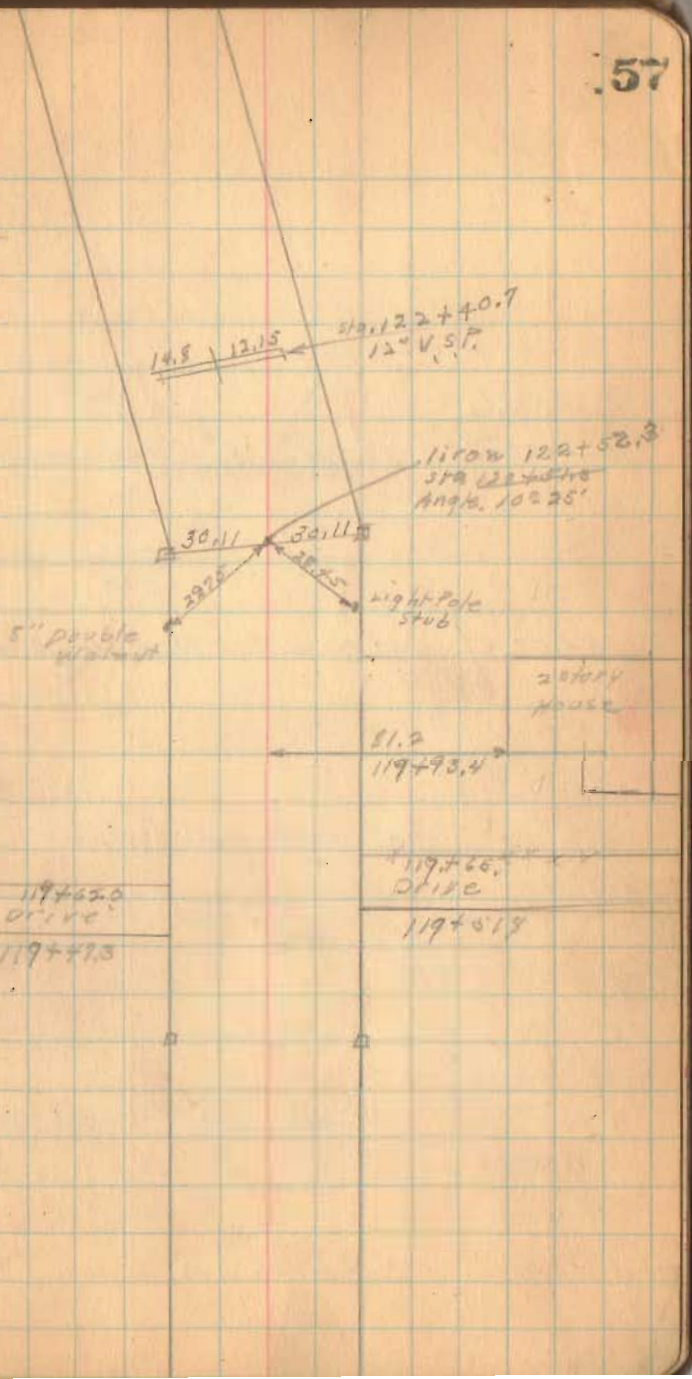

145 + 78.2

~~144 + 78.2~~ Set Hub for Monuments

~~126+00~~ Set Hub for Monuments

~~130+00~~ Set Hub for Monuments

~~135+00~~ Set Hub for Monuments

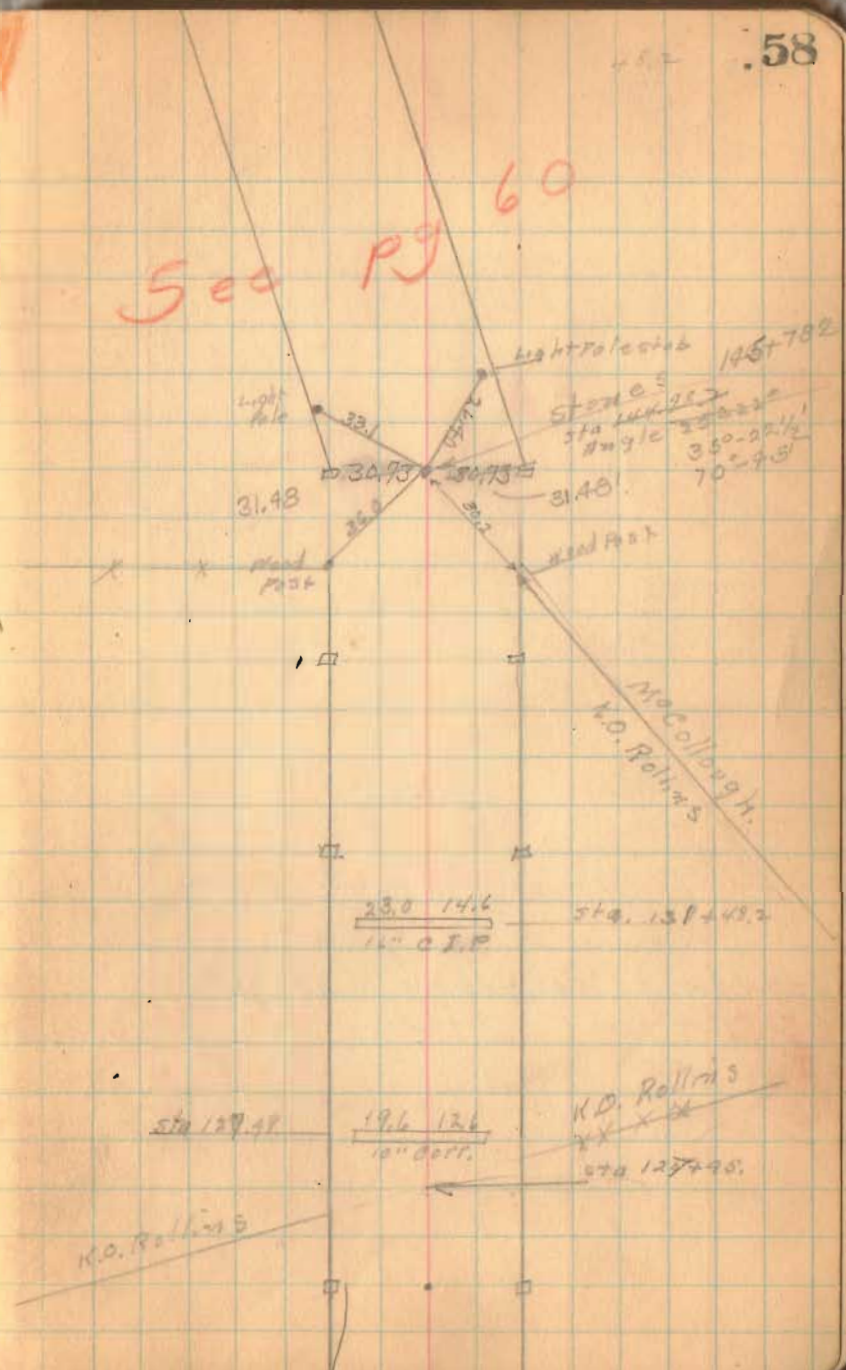

See page 60

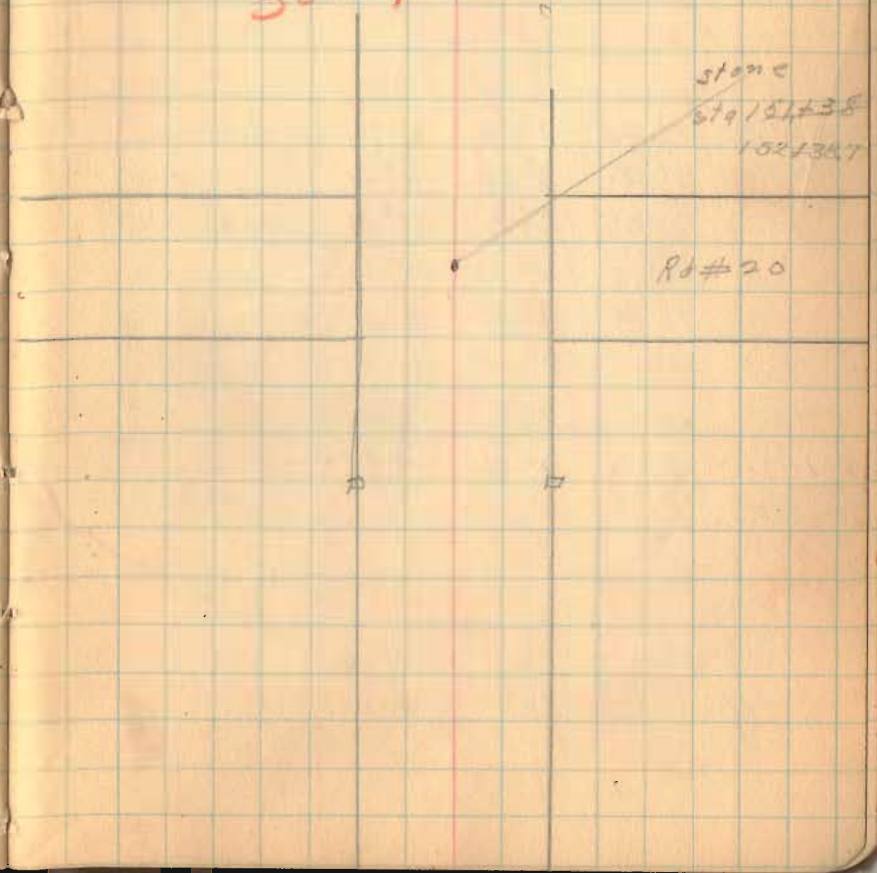

150+00 set Hub for Movement.

Relocation of Rd 5
at Sta 144+78.2

Sta	Distance	Deflection	Total Deflection
146 145+63.275	63.275	1°-20'	17°-41'
+50	50.00	2°-30'	16°-21' ✓
+25	25.00	2°-30'	13°-51' ✓
146 145+00	100.00	2°-30'	11°-21' ✓
+75	75.00	2°-30'	8°-51' ✓
+50	50.00	2°-30'	6°-21' ✓
+25	25.00	2°-30'	3°-51' ✓
145 144+00	13.60	1°-21'	1°-21' ✓
PC 143+06.90 144			

Restaked

Stakes set at 60' for
H. O. Rollins fence.

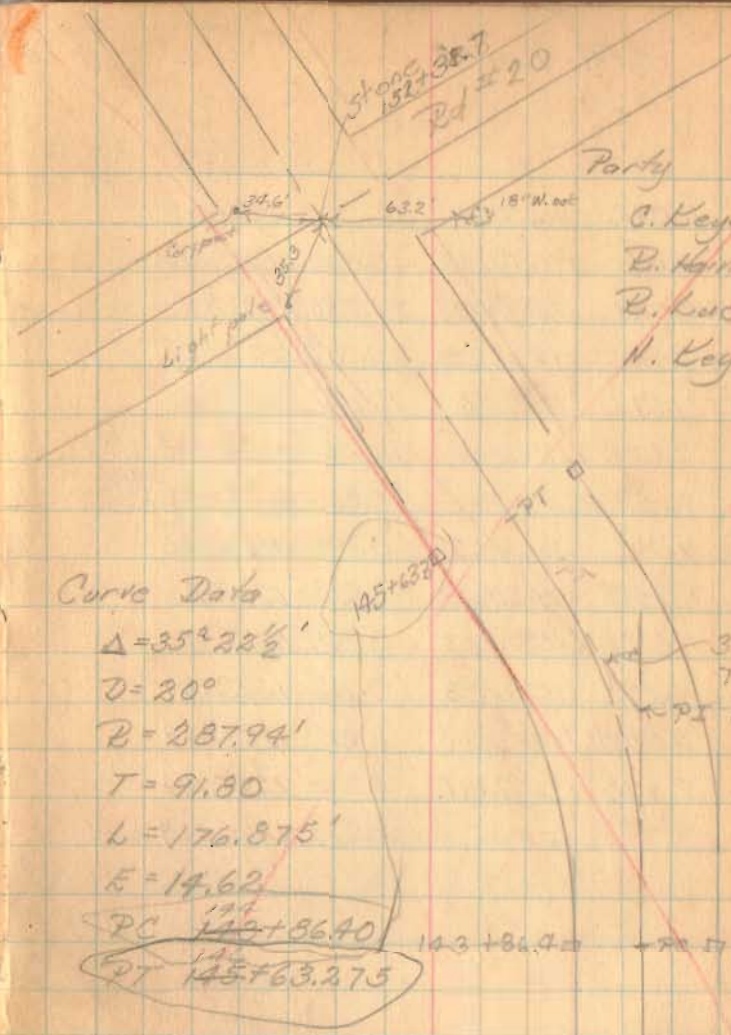

Party
C. Keysor - Ch
R. Haines
R. Lucas
N. Keysor

Curve Data
$\Delta = 35°22\frac{1}{2}'$
$D = 20°$
$R = 287.94'$
$T = 91.80$
$L = 176.875'$
$E = 14.62$
PC ~~140~~ 144+86.40
PT ~~145~~ 145+63.275

□ - Hub