Survey
No 328

851°

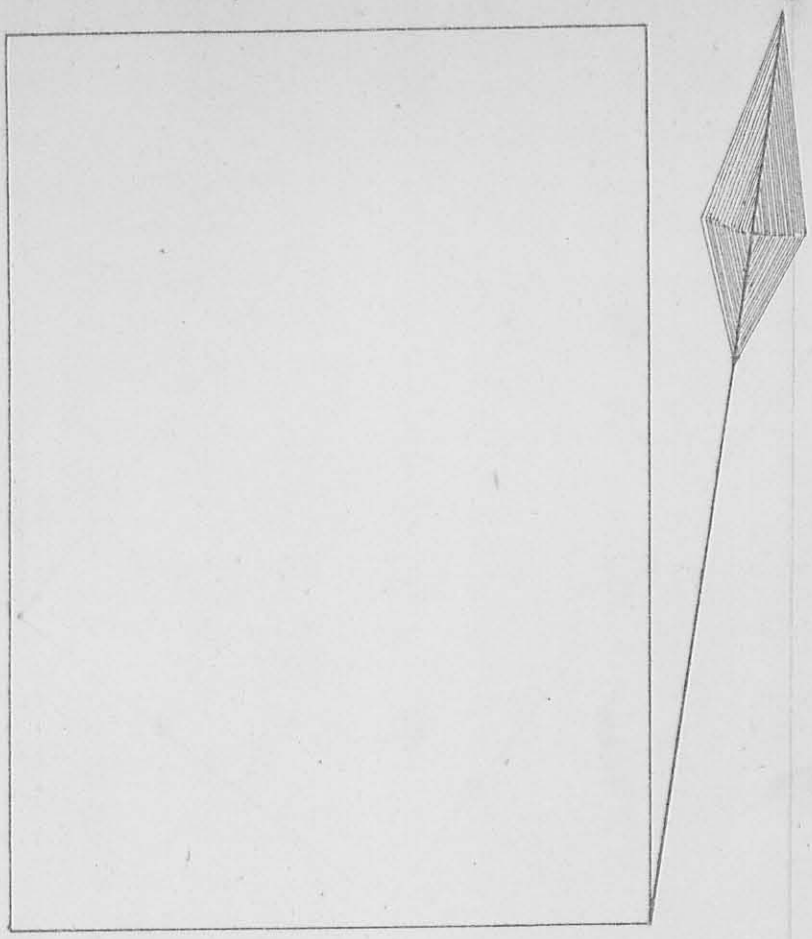

Surveyed August 2 1845 for Thos Dickinson the following lot of land being part of Survey No 3326
Beginning at a Sugar ~~Tree~~ on the ~~bank~~ of Sandy River the same being a corner to said survey
thence S 8 ¼ E 156½ poles to a Stake thence S 8¼ W 134
A poles to a Dog-wood, Iron-wood & Oak (Oak cut
Down & Dog-wood gone) thence N 8¾° W 156½ poles to
2 Beech & Elm (Elm gone) thence N 8¼ E ~~156½~~
134 poles to the Begining containing 156 12/100 Acres
Peter Jamison } A Co — A A Harrison
Benjamin Butler } " " — C S L Co A

2