



INDIAN LAKE

SANDY BEACH PARK

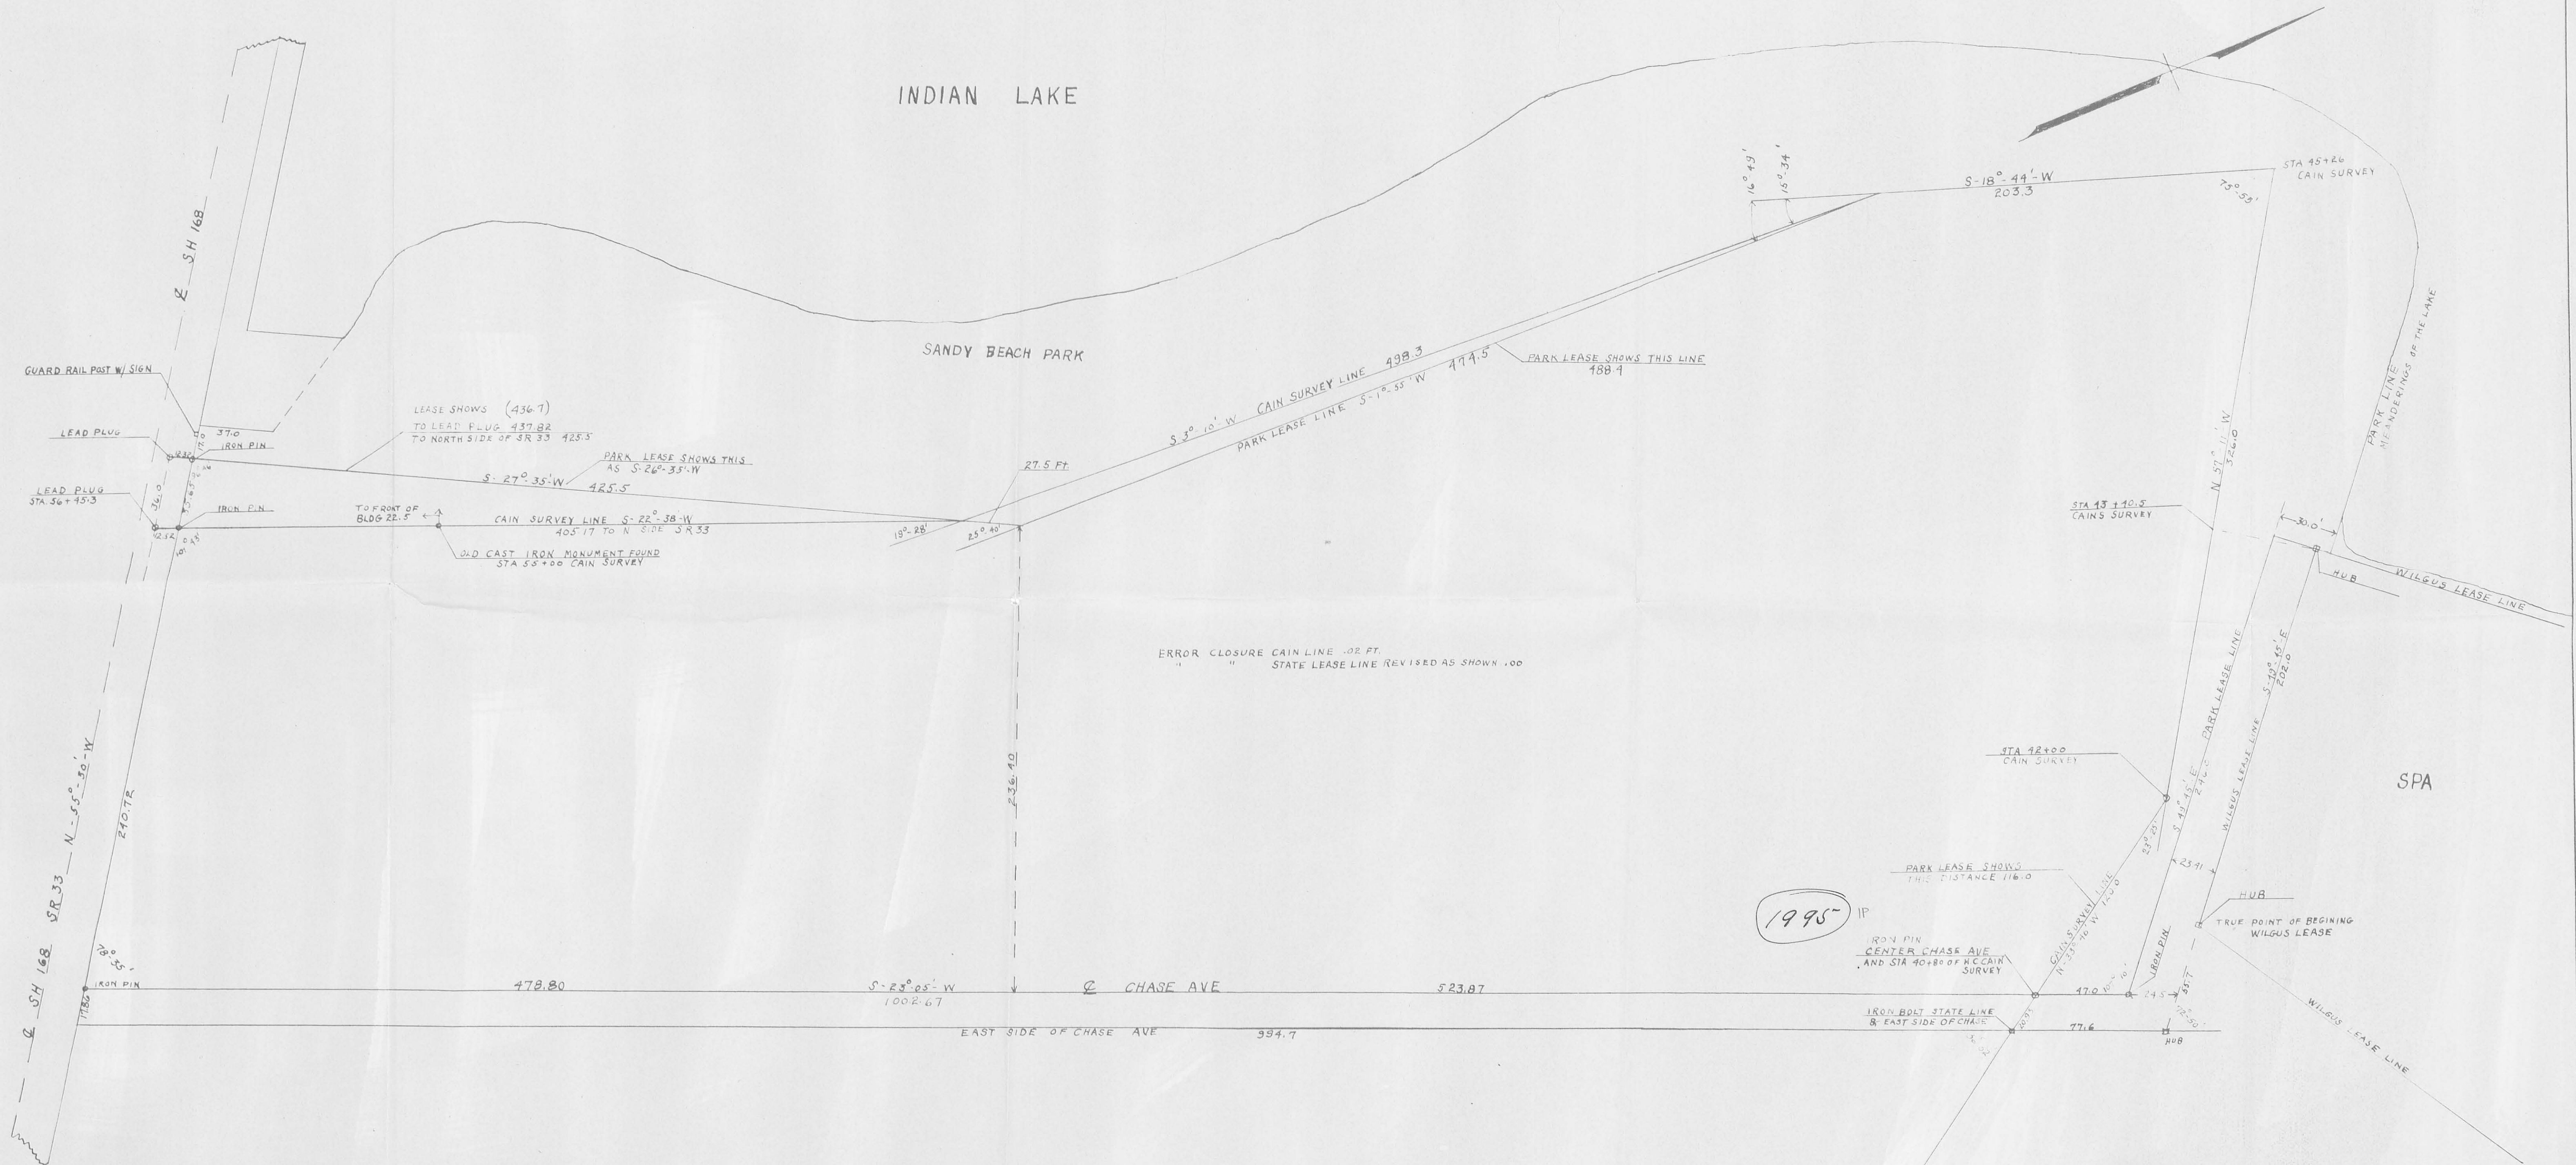

SANDY BEACH PARK  
 RUSSELLS POINT OHIO  
 HOBART H LEWIS  
 ENGINEER  
 CE 2662  
 MARCH 2 1949



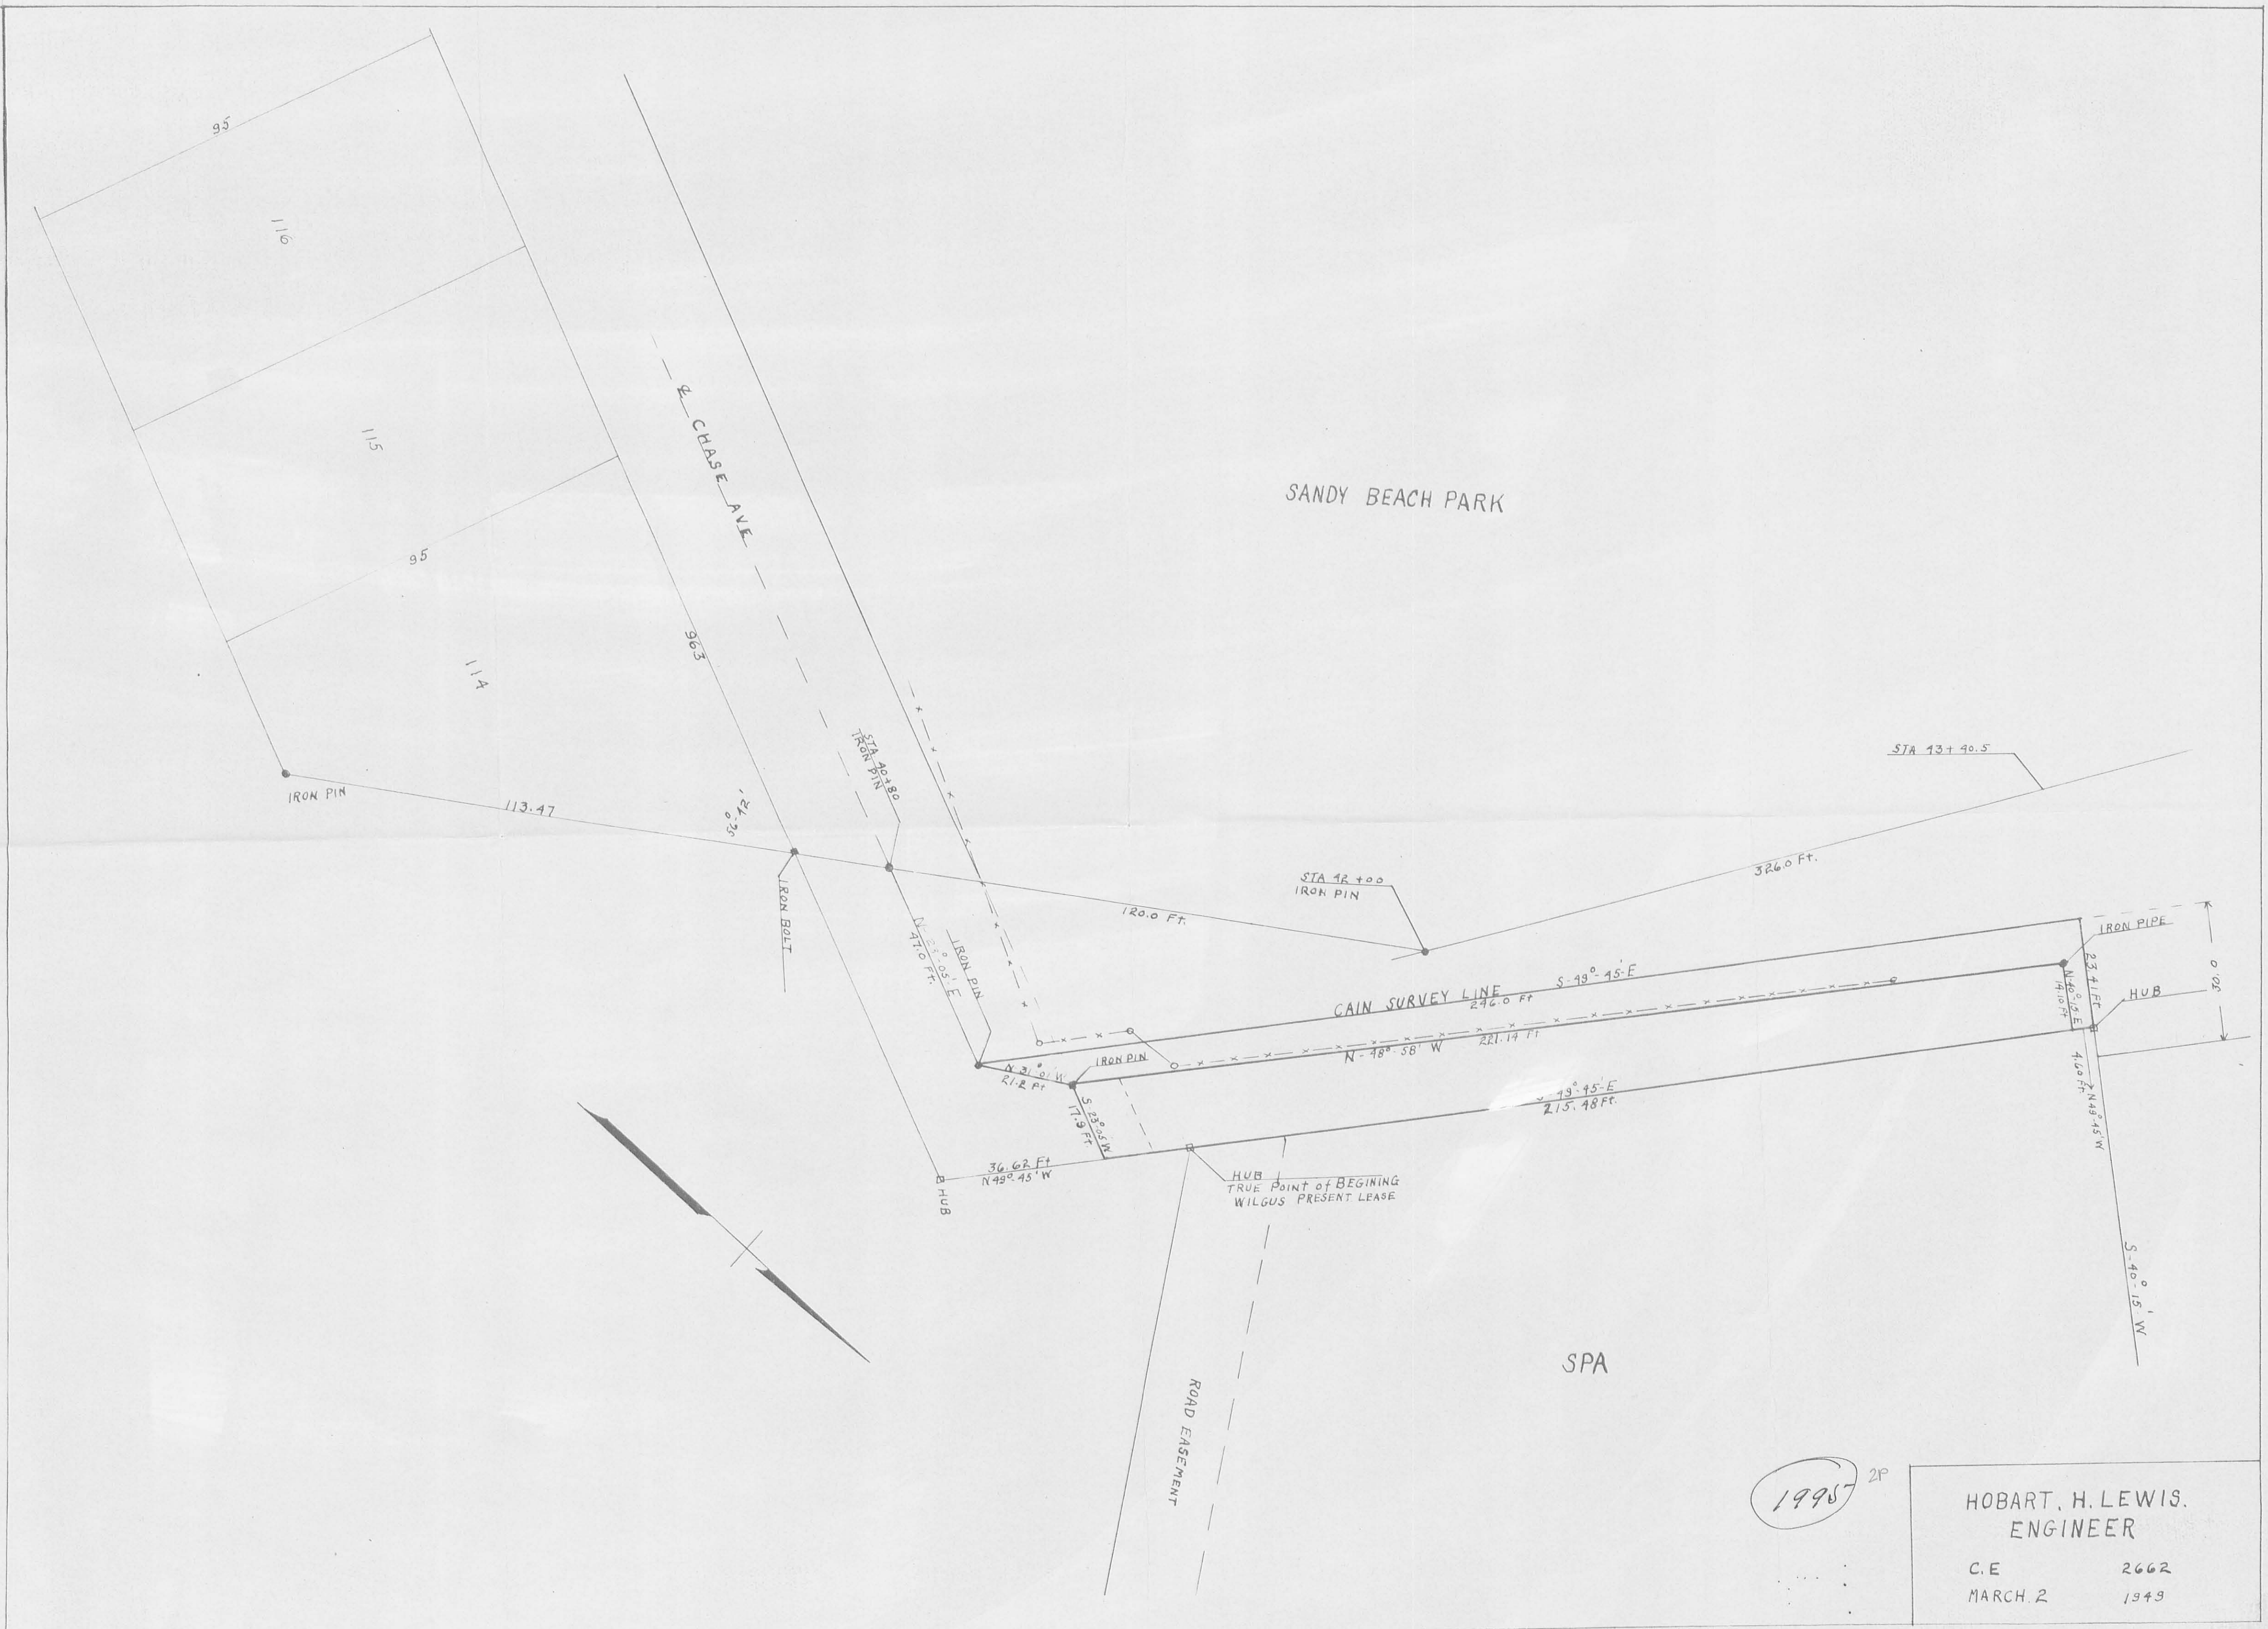

1995 2P

HOBART, H. LEWIS.  
ENGINEER  
C.E. 2662  
MARCH 2 1949