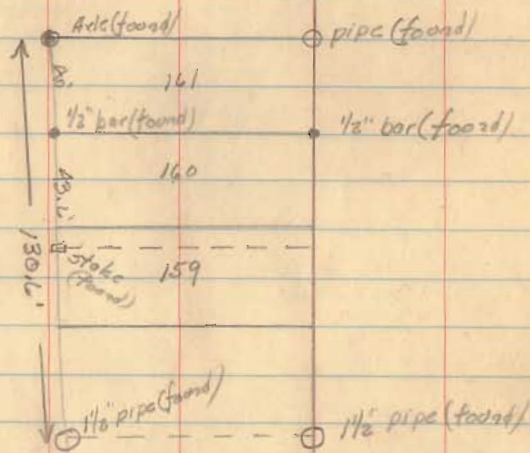


Additional Notes

Mrs Oliver Briggs Job 111

CAlmskeep 6/15/27
F Horrell
Job No. 111Dayton Power
& Lt Co.