Fidler Survey Stokes Township

(140)

INDEXED ON MAP

A Stone Found

B Old Post

C Old Post and Stone found

D Iron Pipe Placed by Wright

E. Iron (Ford well) Placed by Wright

F No stone found Used ¢ of Road. Mr. Fox stated that old post on West side of road was on property line. Measured 25' from post for ¢ of road. Apparently O.K.

A C = 40.08 ch.

Measured from F To D 40.08 ch.

Made E Midway between F and D

Made CD 20.00 ch.

" BE 20.00 ch.

All distances given in chains.

Line ED very bushy

Fidler deed Vol 121 Page 165

Castle " " 121 " 329

Walters " " 113 " 435

(Wanders Lake Survey Book 456)
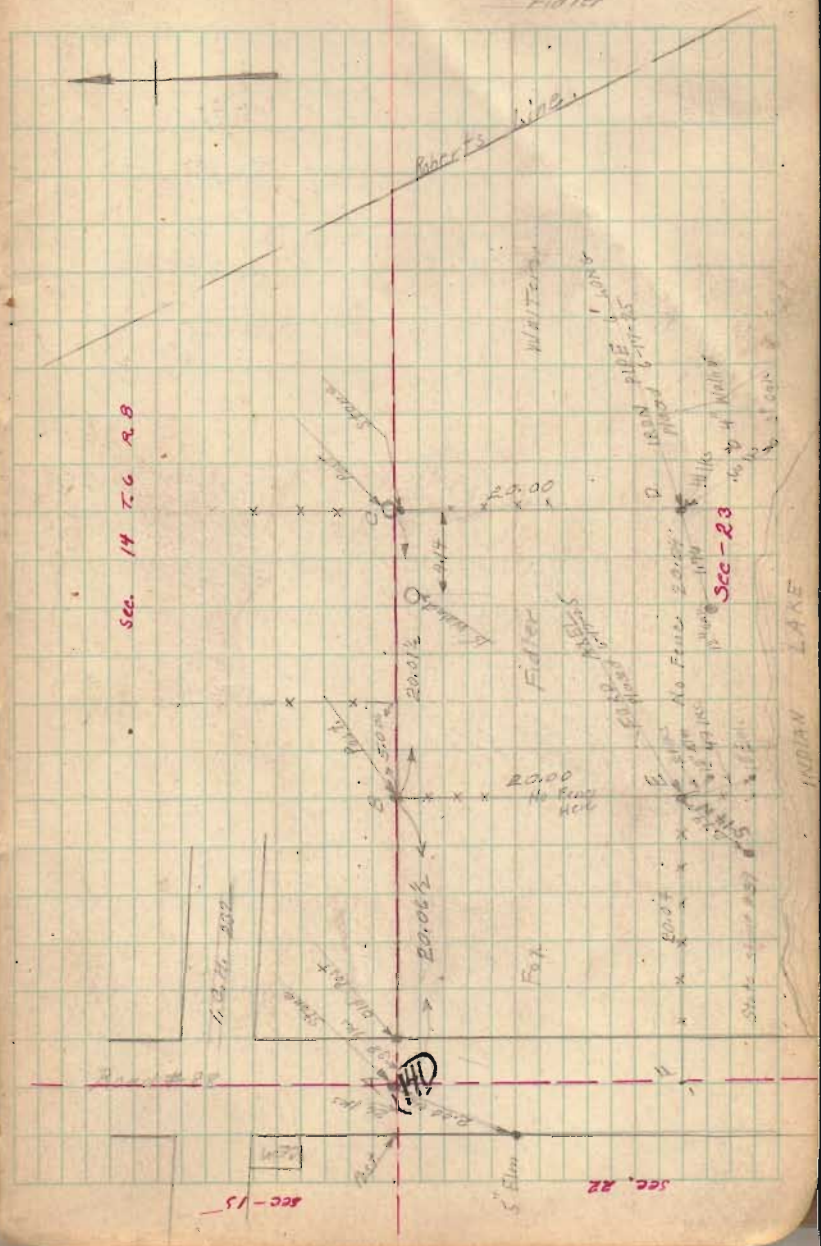
June 17 1925
Thunder Sky
K Wright
Ed. Lee
Fidler