Jerviss survey
Lake View
Stokes Twp

1026 IP
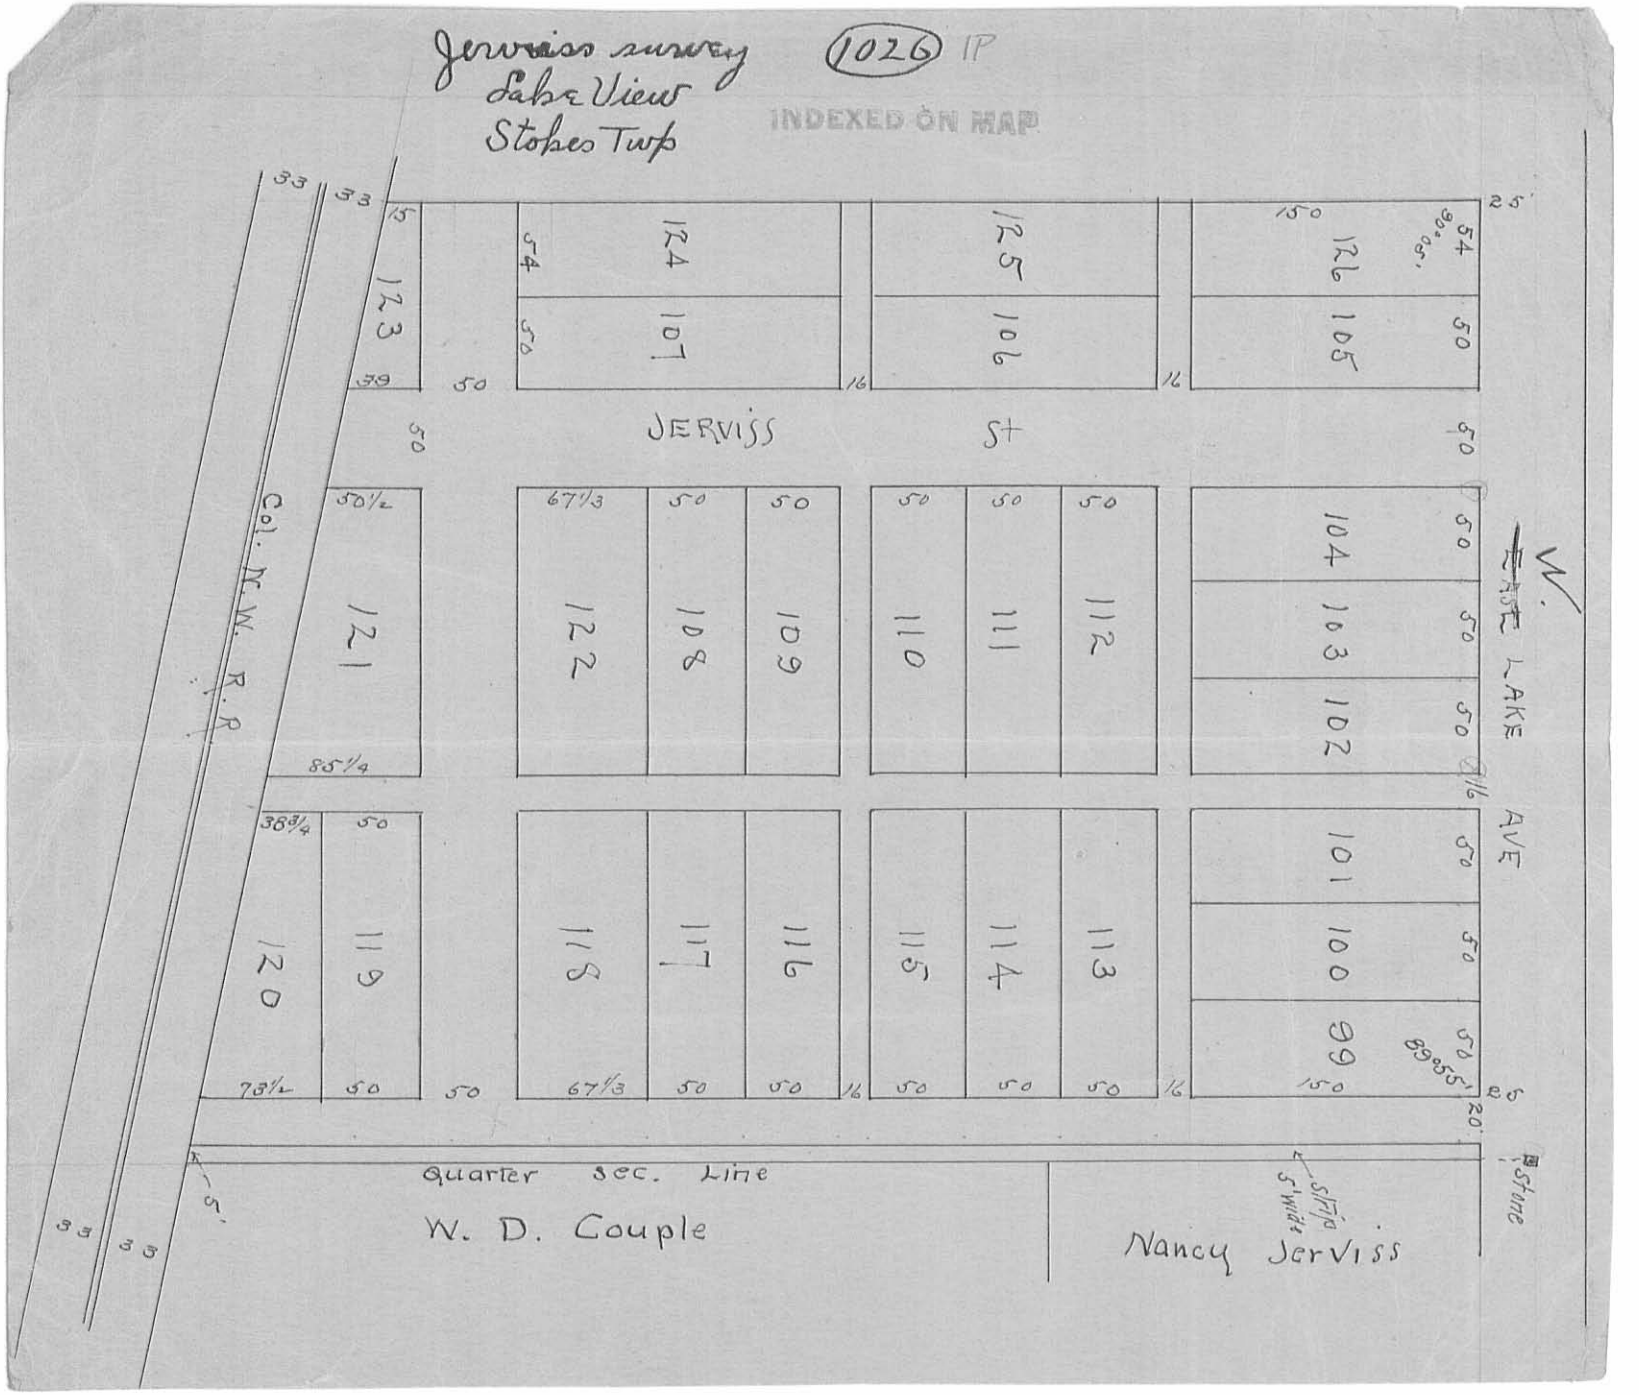
INDEXED ON MAP