Hoefle Survey
Stakes Twp.
Lots. 230-231-232-233
Wise Island View.

A - Same as A. Page 52
B - Hub found. Checked O.K
for Line AD. Placed New Stake
Turn Angle for Line North side
of 233
C. Not Found.
D old Hub found.
E. Not Found
F. Hub placed. Turned N3° as shown.
G. Old Hub found.

INDEXED ON MAP
1249
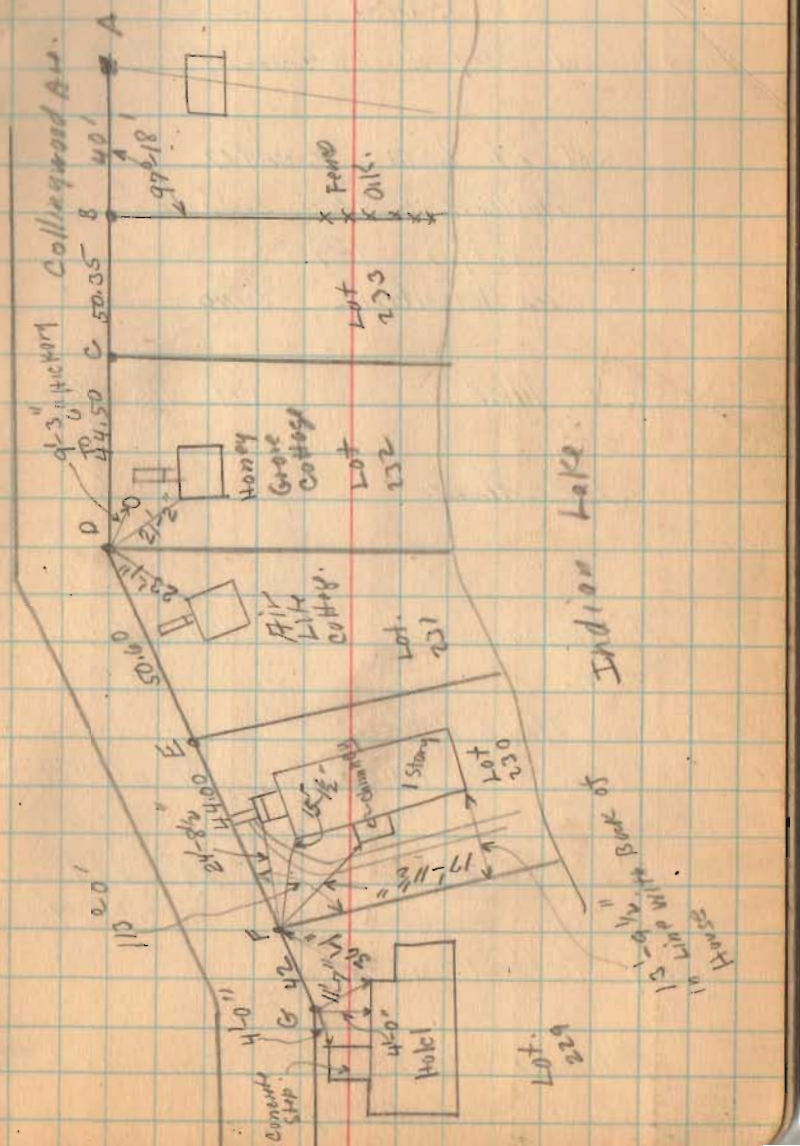
Oct. -6-1931
Warm.
Wright-