LT 15.

SHAWNEE ISLAND
Recorded Plat Book C page 12

and part of 33
33 surveyed 9/30/41

SURVEY of part of
LOT 32 - SHAWNEE ISLAND
YM3 1227L STOKES TWP
LOGAN CO.
Recorded Plat Book C Page 12
for
L.R. Smallman, Marysville, Ohio

at "A"

"A" 2"x2"x12" oak stake set 16' at rt angles to line through pipe at S.W. corner to lot 34 and 16' north of rt L's to pipe found at "D"

"B" 2"x2"x12" oak stake set B on line between "D" and "C" and 187.4' from iron pipe at "D"

Line FE - NE L 107°-30' from E line Lake Drive East.

"C" 2"x2"x18" oak stake set 64.2' from B and 126.3' from E.

Reserve 16' d

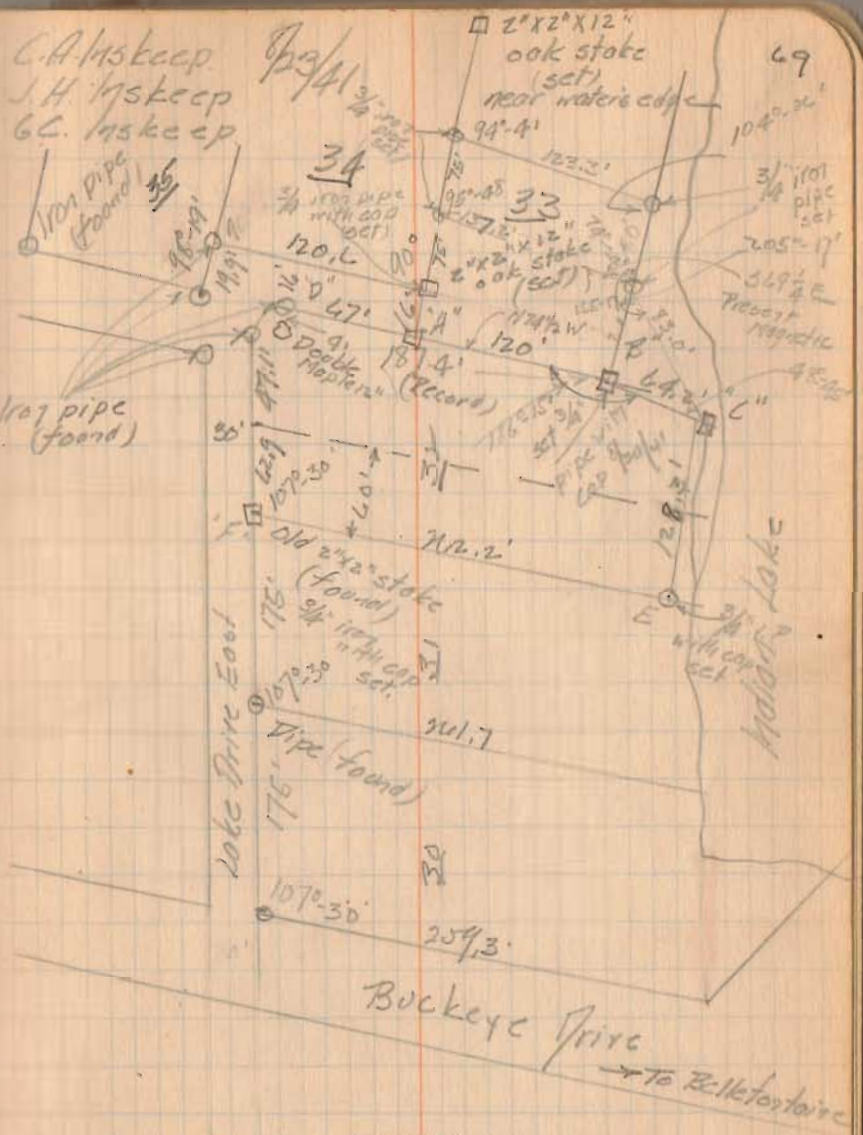

log cp 1.778151
cos 17°-30' .979480
.798671

62.91

2250