92

Survey for Att Recor
Lima, Ohio
VMS 12276 Stakes Twp Logan Co Ohio
"A" pipe 5/8" (found) at root of 3 ashes
"B" old post about 12" diam (found) 1" pipe set
"J"

C 5/8" pipe (found)
K 3/4" iron bar (found)
"D" 1" pipe (set) on line KC and 45' from K
"E" 1 1/2" pipe with cap (found) NE cor Lot 29
"F" 3/4" iron bar (found) NW cor lot 37
G old stake (found) pipe (set)
"J" pipe (found) E cor lot 26 (not applied)
H pipe (set) at record distance from G and record angle with GE
"I" pipe (set) 4' from H and deed angle with HG (in old post)
"L" hub (set) temporary

93

CA Updegrove
CA Munk
FL Howell
11/5/or Election Day

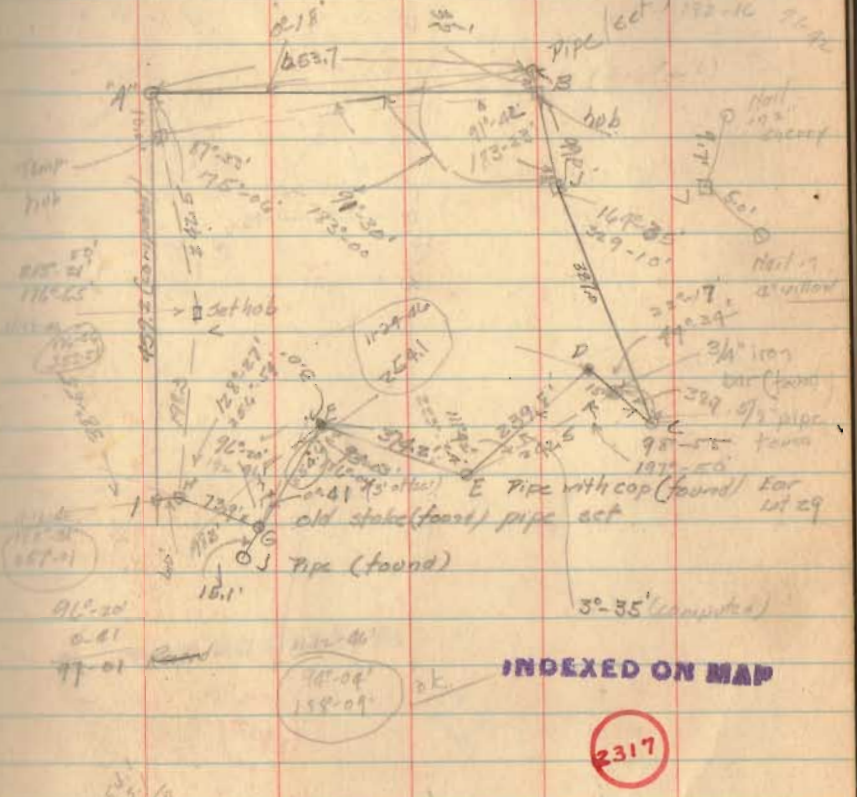

INDEXED ON MAP

2317