SURVEY OF
CHEROKEE PATH
CHIPPEWA No. 1
FOR
STOKES TWP. TRUSTEES

3471
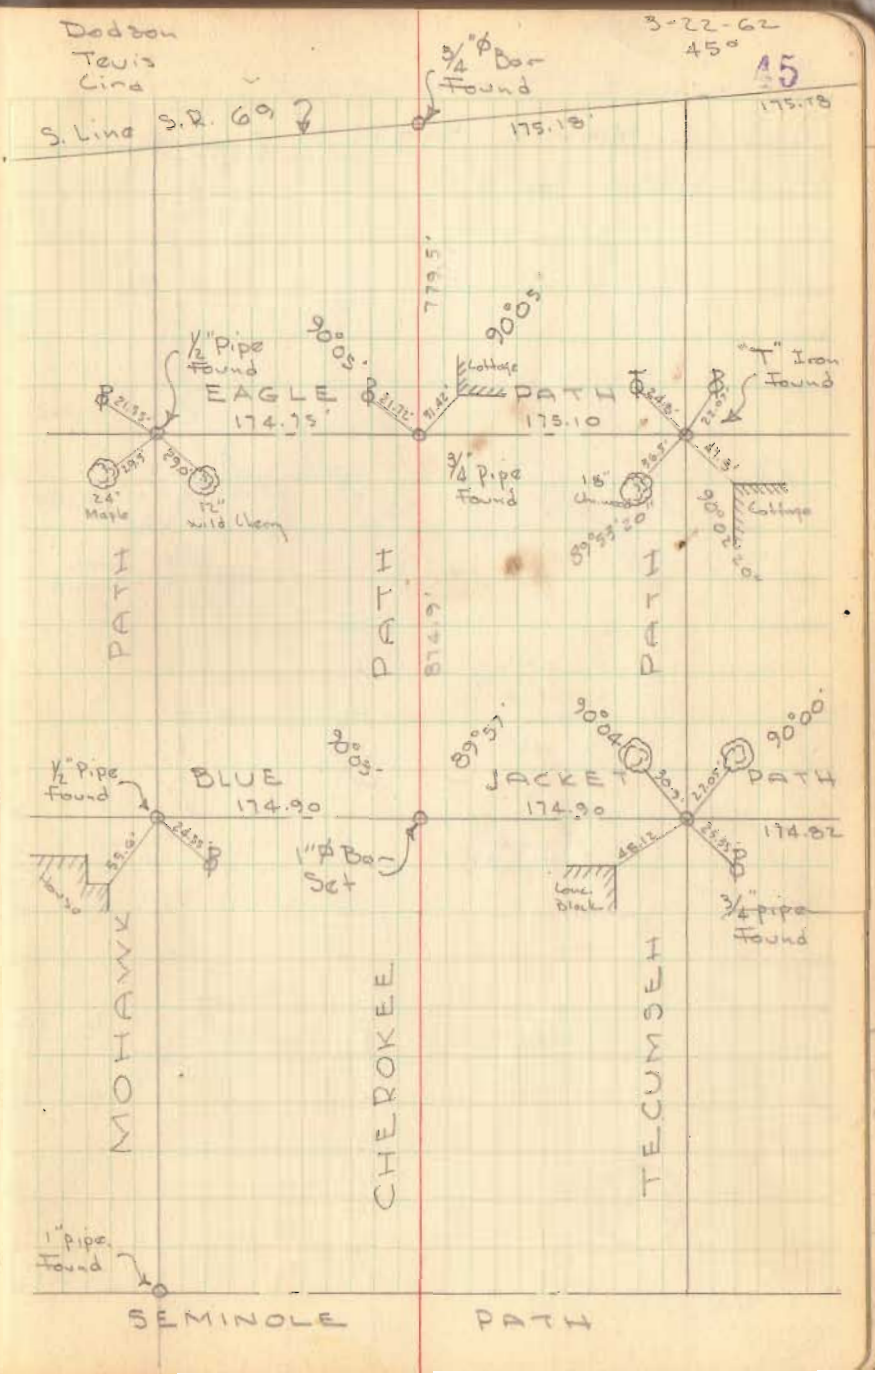
INDEXED ON MAP