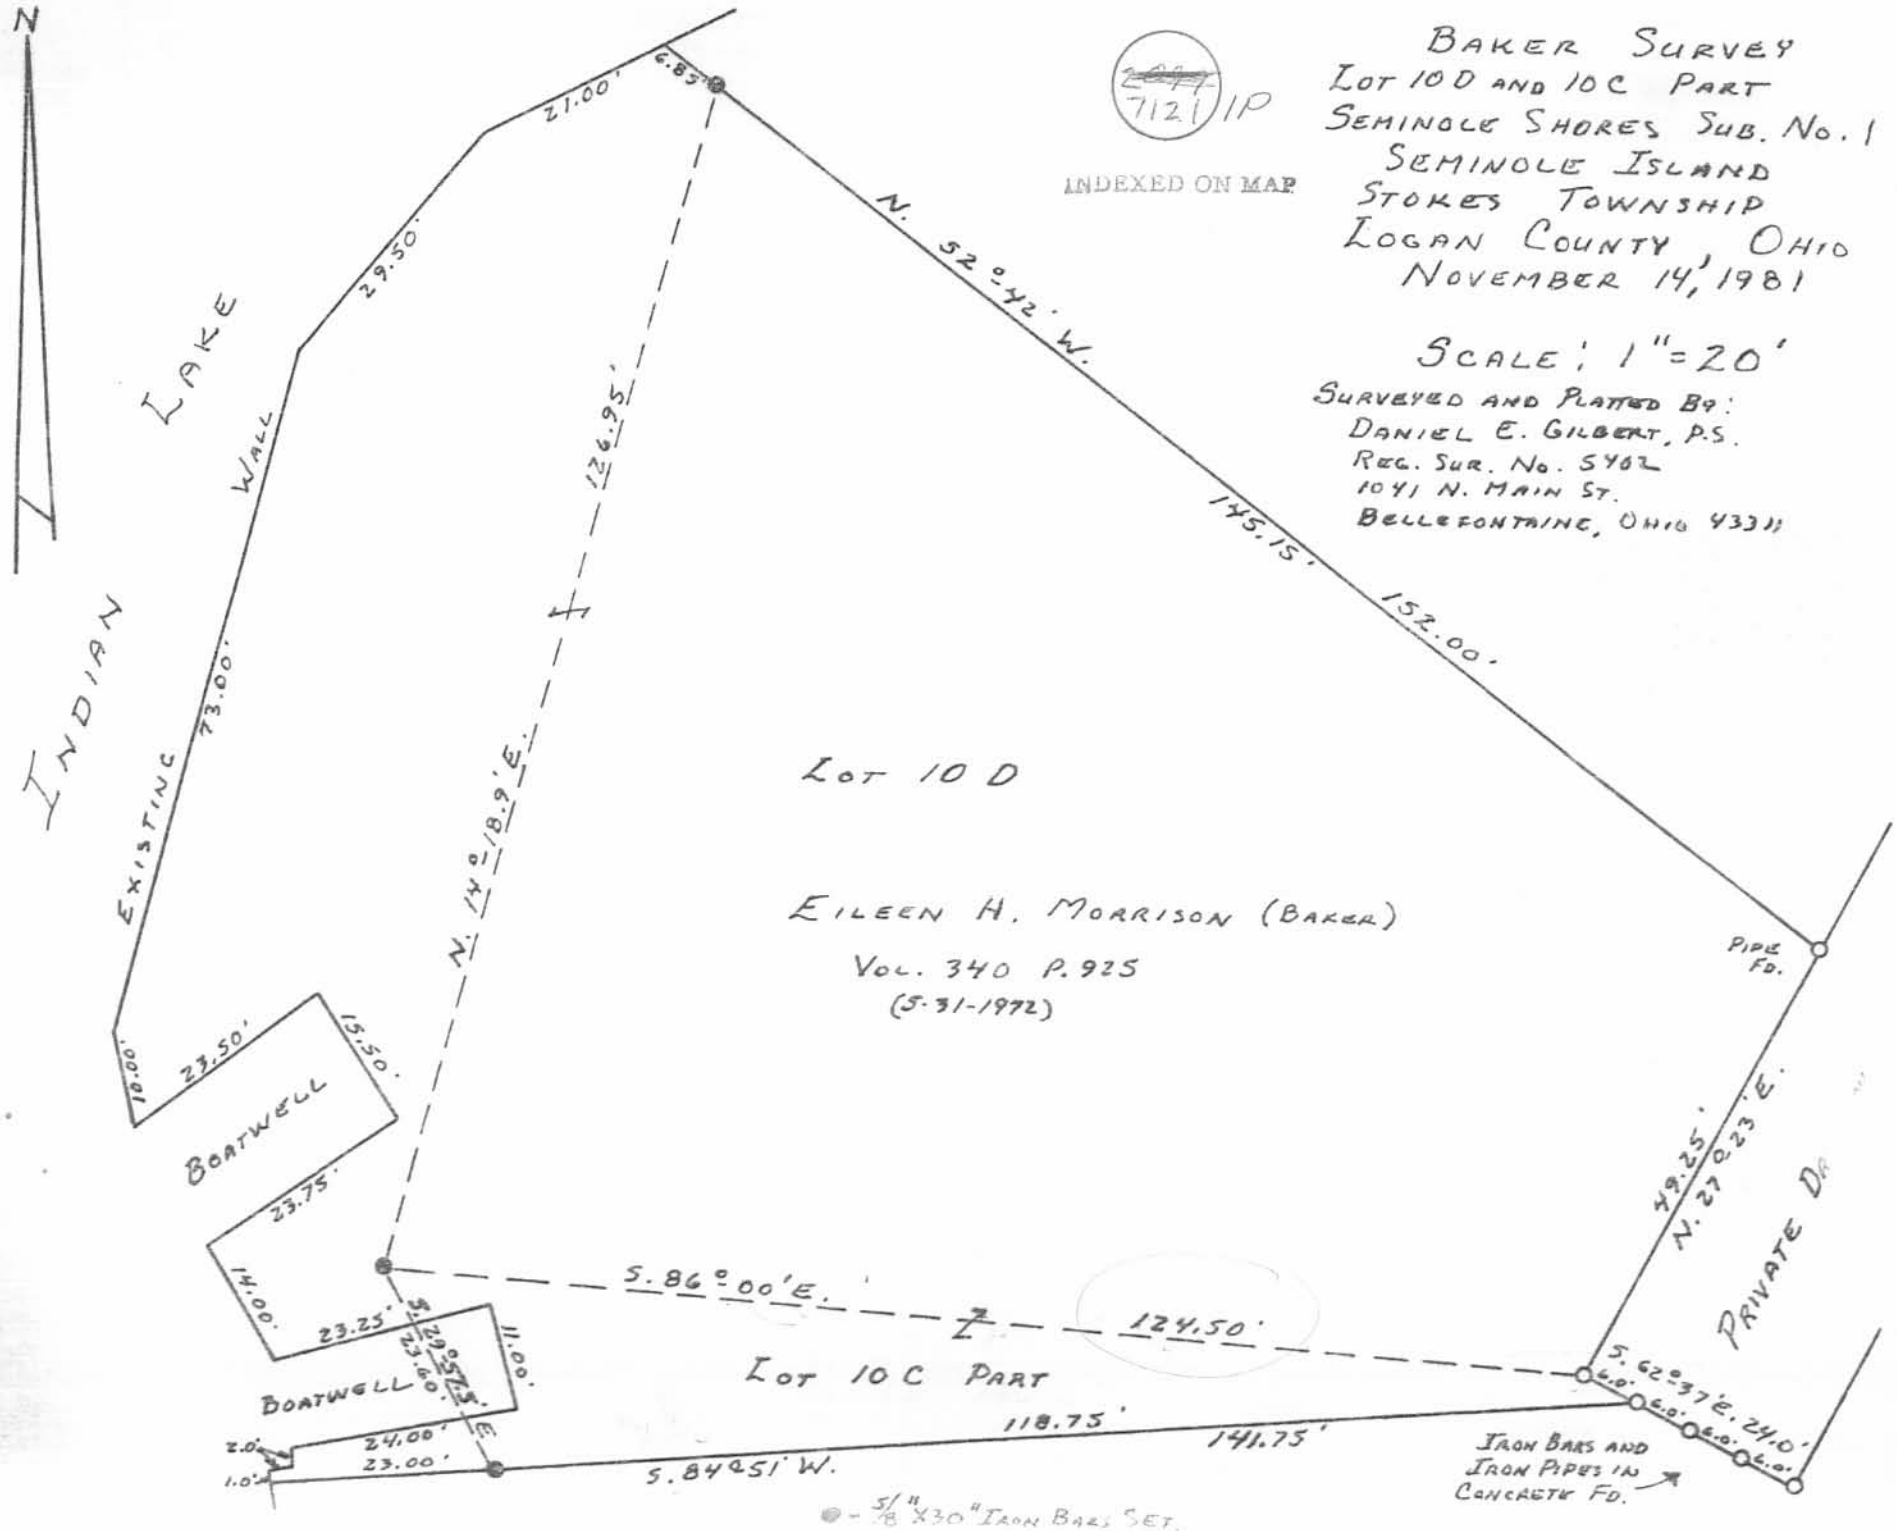

7121 IP

INDEXED ON MAP

BAKER SURVEY

LOT 10 D AND 10 C PART
SEMINOLE SHORES SUB. NO. 1
SEMINOLE ISLAND
STOKES TOWNSHIP
LOGAN COUNTY, OHIO
NOVEMBER 14, 1981

SCALE: 1" = 20'

SURVEYED AND PLATTED BY:
DANIEL E. GILBERT, P.S.
REG. SUR. NO. 5402
1041 N. MAIN ST.
BELLEFONTAINE, OHIO 43311