

BLUE JACKET PATH (35')



LEGEND

- 5/8" IRON ROD SET
- PK NAIL SET

REFERENCES

LOGAN COUNTY ENGINEER'S FILES:
R-6236, R-6250, AND R-7352
PLAT BOOK B, VOL. 2, PG. 126 & 127


**RETRACEMENT SURVEY OF
LOTS 252, 253, AND 254
OF CHIPPEWA PARK ALLOTMENT NO. 1
PLAT CABINET A, SLIDE 223
VIRGINIA MILITARY SURVEY 12276
STOKES TOWNSHIP
LOGAN COUNTY, OHIO**

SURVEYED BY:

(Signature)

JEFFREY I. LEE
PROFESSIONAL SURVEYOR 6359
JUNE 24, 1996

INDEXED ON MAP
9279 IP

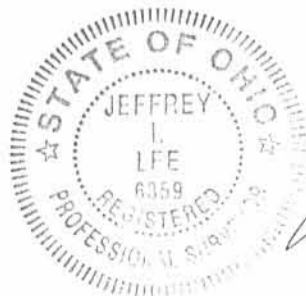

2 WORKING DAYS
BEFORE YOU DIG

CALL TOLL FREE **800-362-2764**
OHIO UTILITIES PROTECTION SERVICE.

COPYRIGHT 1996 BY:
LEE SURVEYING & MAPPING CO., INC.
143 East Columbus Avenue
BELLEFONTAINE, OHIO 43311
(513) 593-7335

ORIGINAL SURVEY MAP

D 285 NROBNSN

L-2420-4

Lot 311-312
CHIPPewa No. 1

35.01
17.3

52.51

Blue Jacket

3/4" Pipe

350.12

R.R. Spk
185.60

175.07

175.07

1" Pipe

CHICKOKEE

TECOMSEH

BIG BEAR

HIWATHA

1" Pipe

352.64

175.55

175.15

180.58

1/2" Pipe
Fnd

3/4" Pipe
Fnd.

1" Pipe

Dodson
Rick Bruce

8/21/73

21

R.R. Spk

Spk

Blue Jacket

89.0
179.0
179.0
57.5
57.5
57.5

70.03

35'

52.5'

35.01

313

17.50

70.03

HIWATHA

70.07

35.01

312

35.01

311

70.03

INDEXED ON MAP
9079