(5)

10-11-44
Dysert
Robbins
McAdams

T-3-R-14

1/4 · 25/30

T4-R-13
1944

Found Large pointed stone and wood stake 2"x2"x12"
Removed same and placed Concrete Mon. Full (4') Length-4'
Top 20" below surface of Road
Marked As Above

See Book 516 p. 72

28

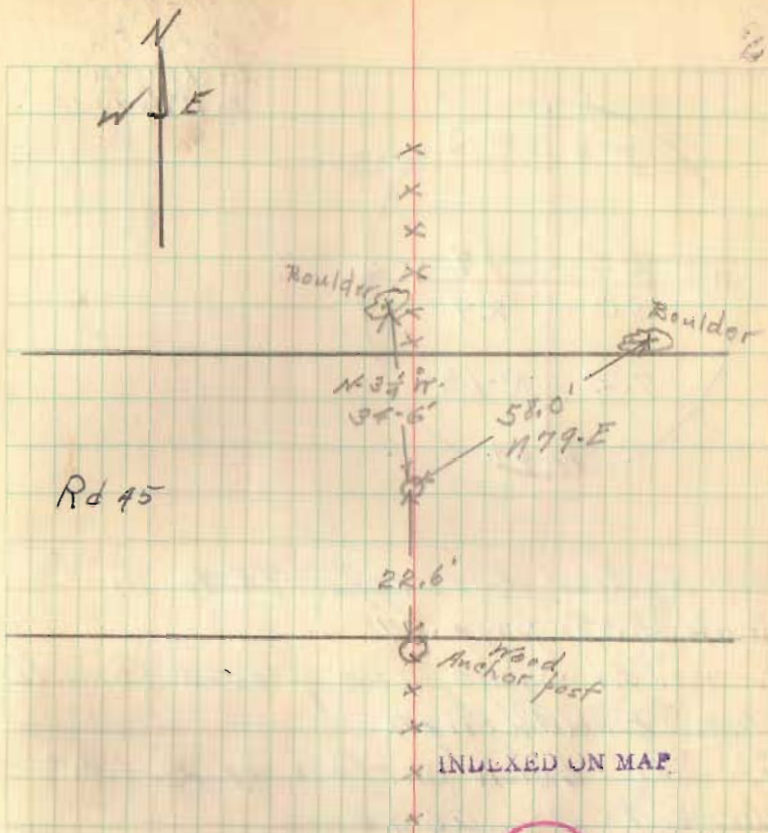

INDEXED ON MAP

2642 Union Twp.
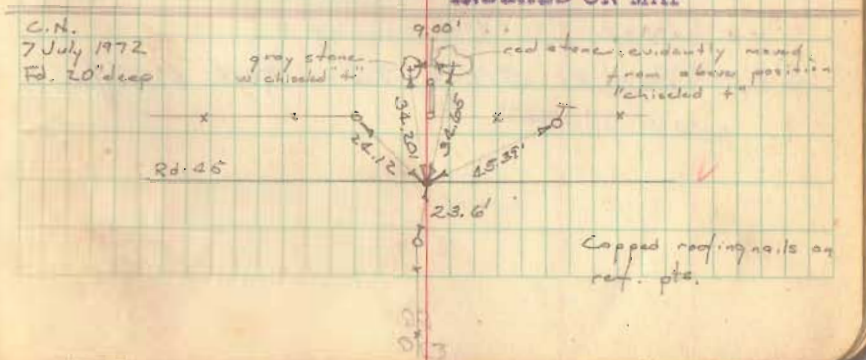
INDEXED ON MAP