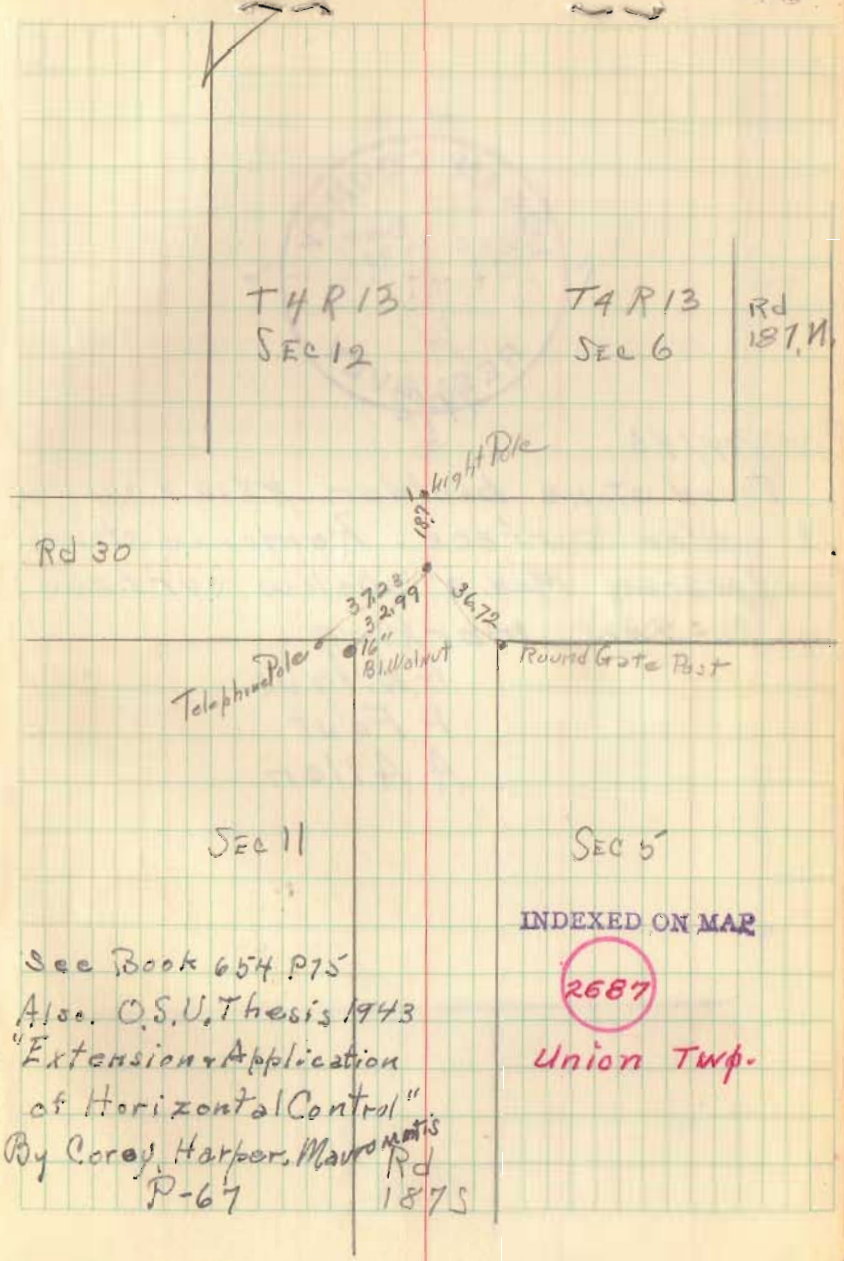5/3/43
Found flat stone 2" x 8" x 13" with brick around it. Removed stone and placed Mon. 4" below surface
J.H. Inskeep
Lane Kerns
Paul Yout