

of the sec 80 poles from the SW corner thereof

The 3^d line begins at the gr sec. corner in the west line of the sec. Thence S 9 1/2 E 340 poles, passing the central corner, to a small white oak in the centre of the east line - The 4th line begins at a stone 80 poles, west of the last named corner; Thence N 9 E 172 poles to a stone a hickory S 25 W 26 L. in the north line 80 poles west of the NW corner of the sec. The number of acres, and the owner's names are marked on each division of the plat.

La McMarnow
C, S, L, C,

Sam. Moon } 66
David Peall

R Clark 9th mo. Sept, 29th 1832

Surveyor 195 B.C.


Surveyed the east half of the N.E. gr of sec. 24 T 4 R 13 M.D. for Robert Clark. - beginning at the gr. sec. corner between sec 18 & 24 a stone in a prairie from which a red oak bears N 20 E 150 L. an original bearing tree thence between Secs 18 & 24 cr & N E 162 poles to the N.E. corner of said sec. a white oak C 8 N 17 L a white oak N 16 1/2 E 34 L - Thence N 89 1/2 W with the original line 80 poles to a stone, a bur oak S 76 E 68 L - Thence S 7 W

162 poles to a stake in a prairie thence C 89 1/2 E.

80 poles to the beginning, containing 88 acres

Layton Pollock }

John Wren } 66

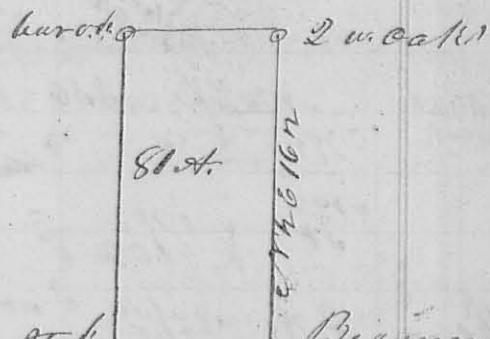

La McMarnow C, S, L, C,

Beginning

Lake Leinen ¹⁸²⁸ 10 mo. Oct 8th 1832

Surveyor 196

by J. H. Farmer I. desurveyed and divided Zadock Walker's Survey no 676 for Lake Leinen

at the request of his atty John H. Farmer

Beginning at a white a dead black oak in Lad. Louis line N.W corner of Hamer Washington's survey