Survey of Lot 485
on Orchard Island.

124
INDEXED ON MAP
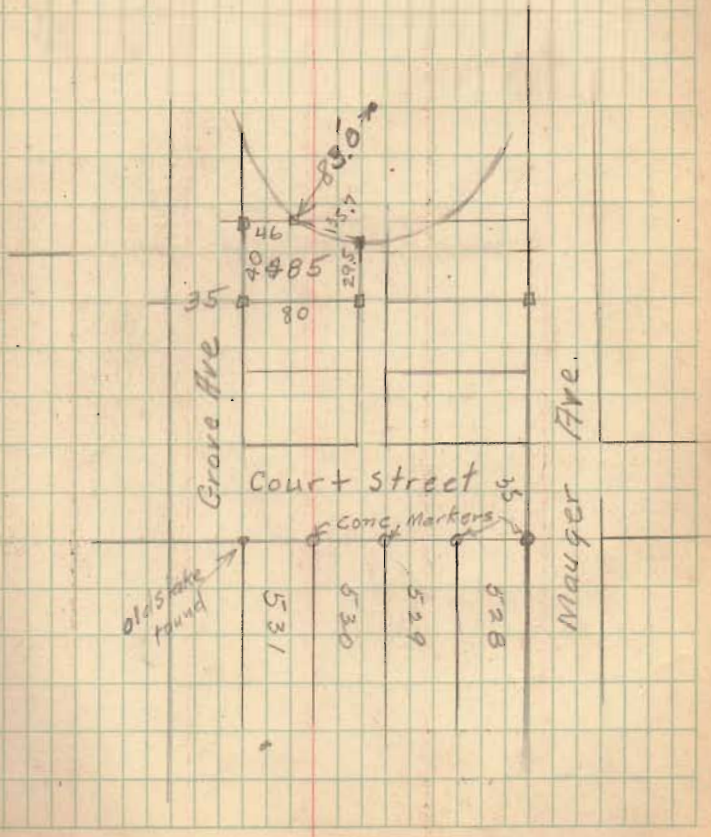
3/21/25
Montgomery
Keller.