Road # 239
Washington and Stokes Township
Sec. 35 T.6 R.8

A - Same Point at "A" Book 418 Page 16.
Old iron gone. Replaced with $1\frac{1}{4}$" Iron 36" Long.

C. Point in Fence Line.

B: Point $\frac{1}{2}$ way Between A and C.

AC = 21.3'

D ℄ Road 20' from E.

E 1" Iron Pipe S.E. Cor. of Midway Place

Mr. Combs claimed ℄ of Road should be AD.
Mr. Anderson " " " " " " CD.
After some discussion Mr. Combs and Mr. Anderson agreed to have ℄ of road B.D.
Road to be 40' wide.
Men Present
Clay Harmon
John Anderson
Combs
R.O. Prior
Steve Prior
John Marrer
Le Poild

See Book 418 Pages 15 and 16 for former survey.

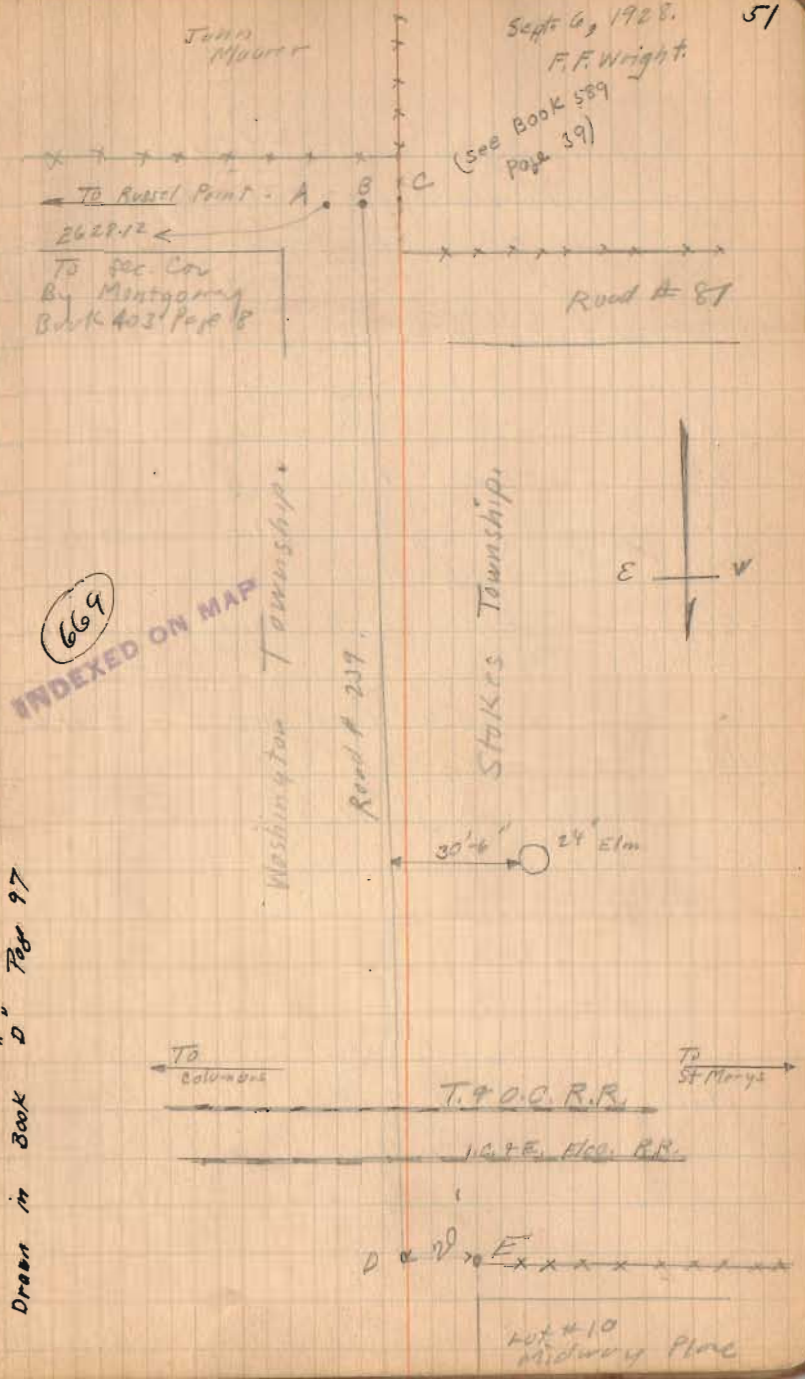

Drawn in Book "D" Page 97