Orchard Island.
Lot. 132

(1658)

INDEXED ON MAP

May—8—1935
Fine day
F. Wright
E. C. K.
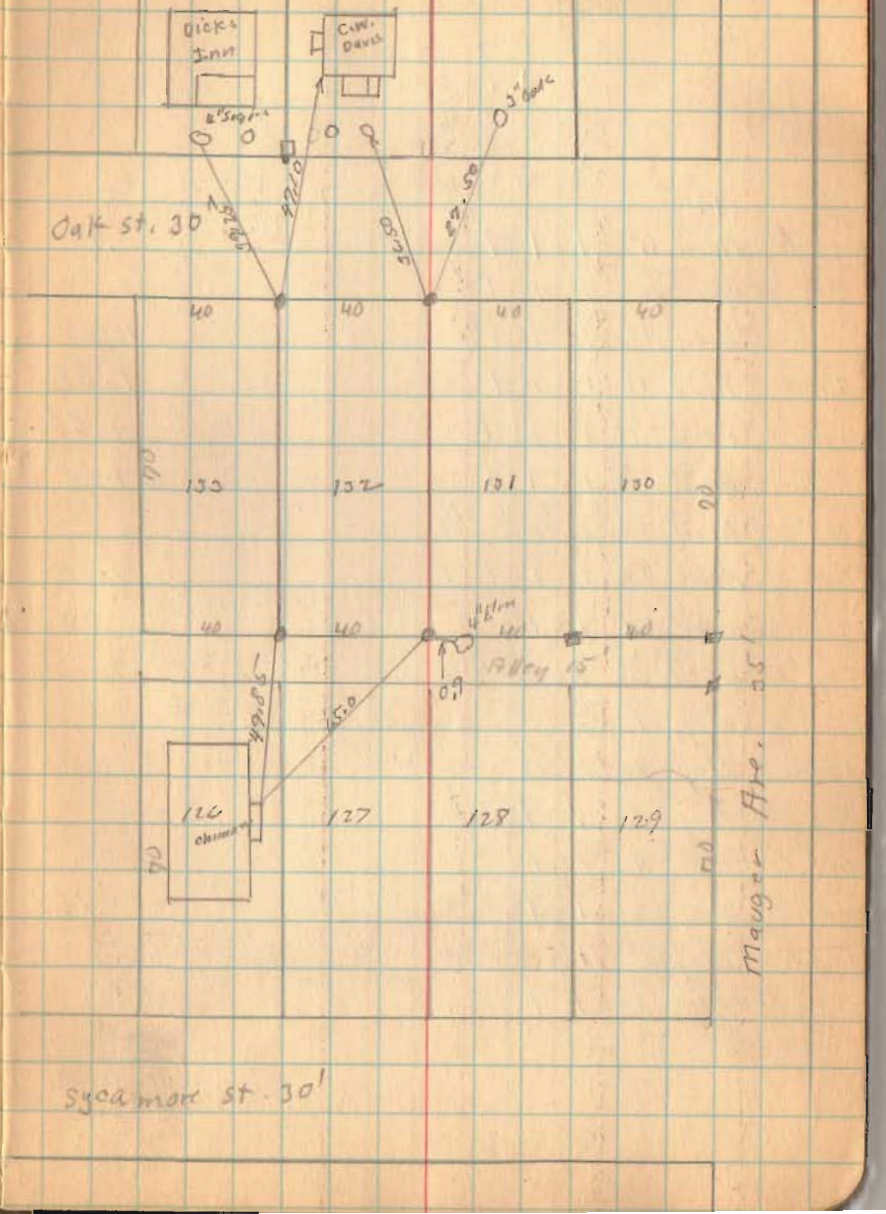
34