Job No 126 Survey of 0.275 Acres
in VMS 12276 Washington Twp
Logan Co Ohio for
CL Breakfield 4620 Springfield St
Dayton Ohio

See Co Eng Book 417 pages 35 & 52

A 2" iron pipe (found) on line with N side 24" □
brick post accepted SW cor 0.55 A tract

B 1/2" iron pipe (found) accepted SW cor Lot 610

C pipe (set) on line with B and 1½" N of corner of wall
See Co Eng book 417 page 52

D pipe (set)

E pipe (set)

2 pipes
2 stakes

C Alnekeep 5-12-47
Robt. Hughes
F L Haven

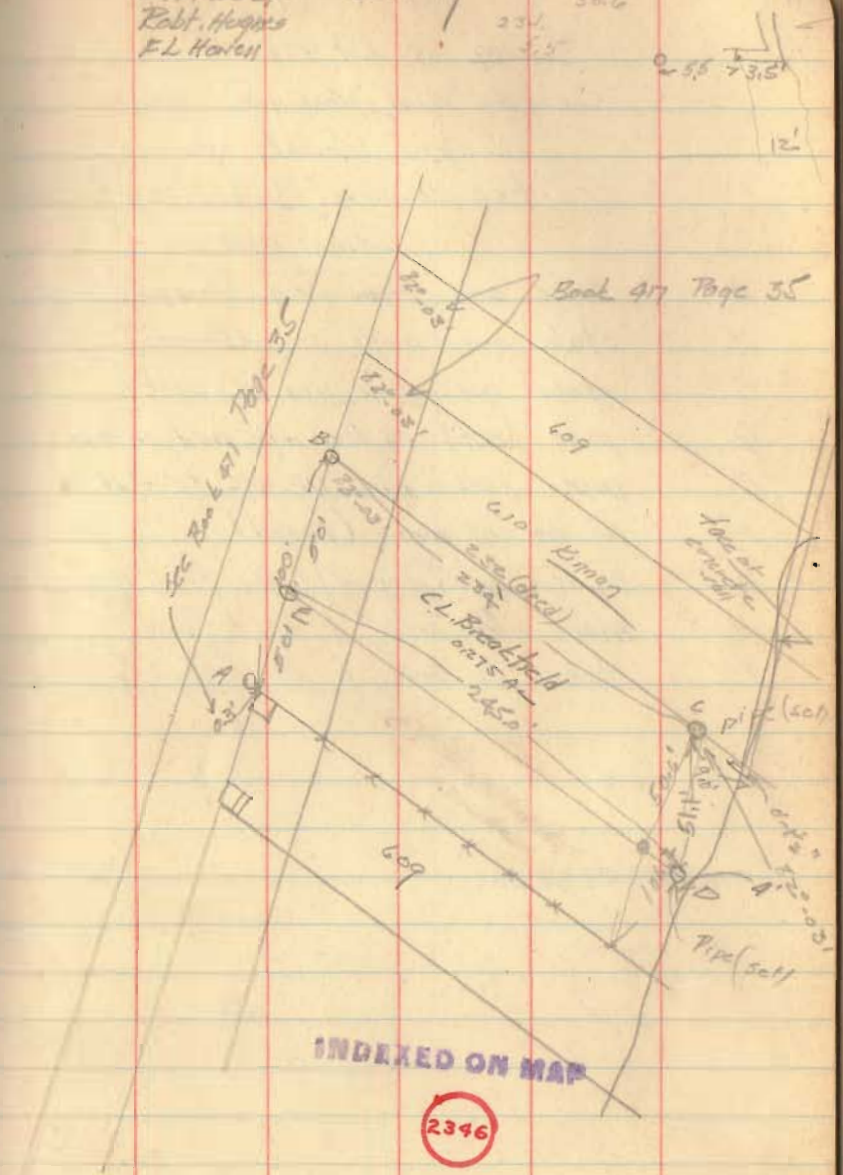

INDEXED ON MAP
2346