

Weber Survey West Liberty Part of Lots 344 - 345 June 1966

The following described being part of Lots 344 and 345 in the Village of West Liberty, Liberty Township, Logan County, Ohio.

Beginning at an iron at the S.W. corner of Lot Number 345 and being at the north side of The Pickrelltown Road and at the east side of Race Street. Thence with the east side of Race Street north 86.00 feet to an iron.

Thence east 86.00 feet to an iron. The last described line passing the east side of Lot Number 344 and the west side of Lot Number 345 at 50.00 feet.

Thence south 86.00 feet to an iron at the north side of The Pickrelltown Road. The last described line being 14.00 feet west of and parallel with the east side of Lot Number 345.


Thence with the north side of The Pickrelltown Road West 86.00 feet to the place of beginning. The last described line passing the west side of Lot Number 345 and the east side of Lot Number 344 at 36.00 feet.

cc  
Logan County Engineer



INDEXED ON MAP

3946 2D

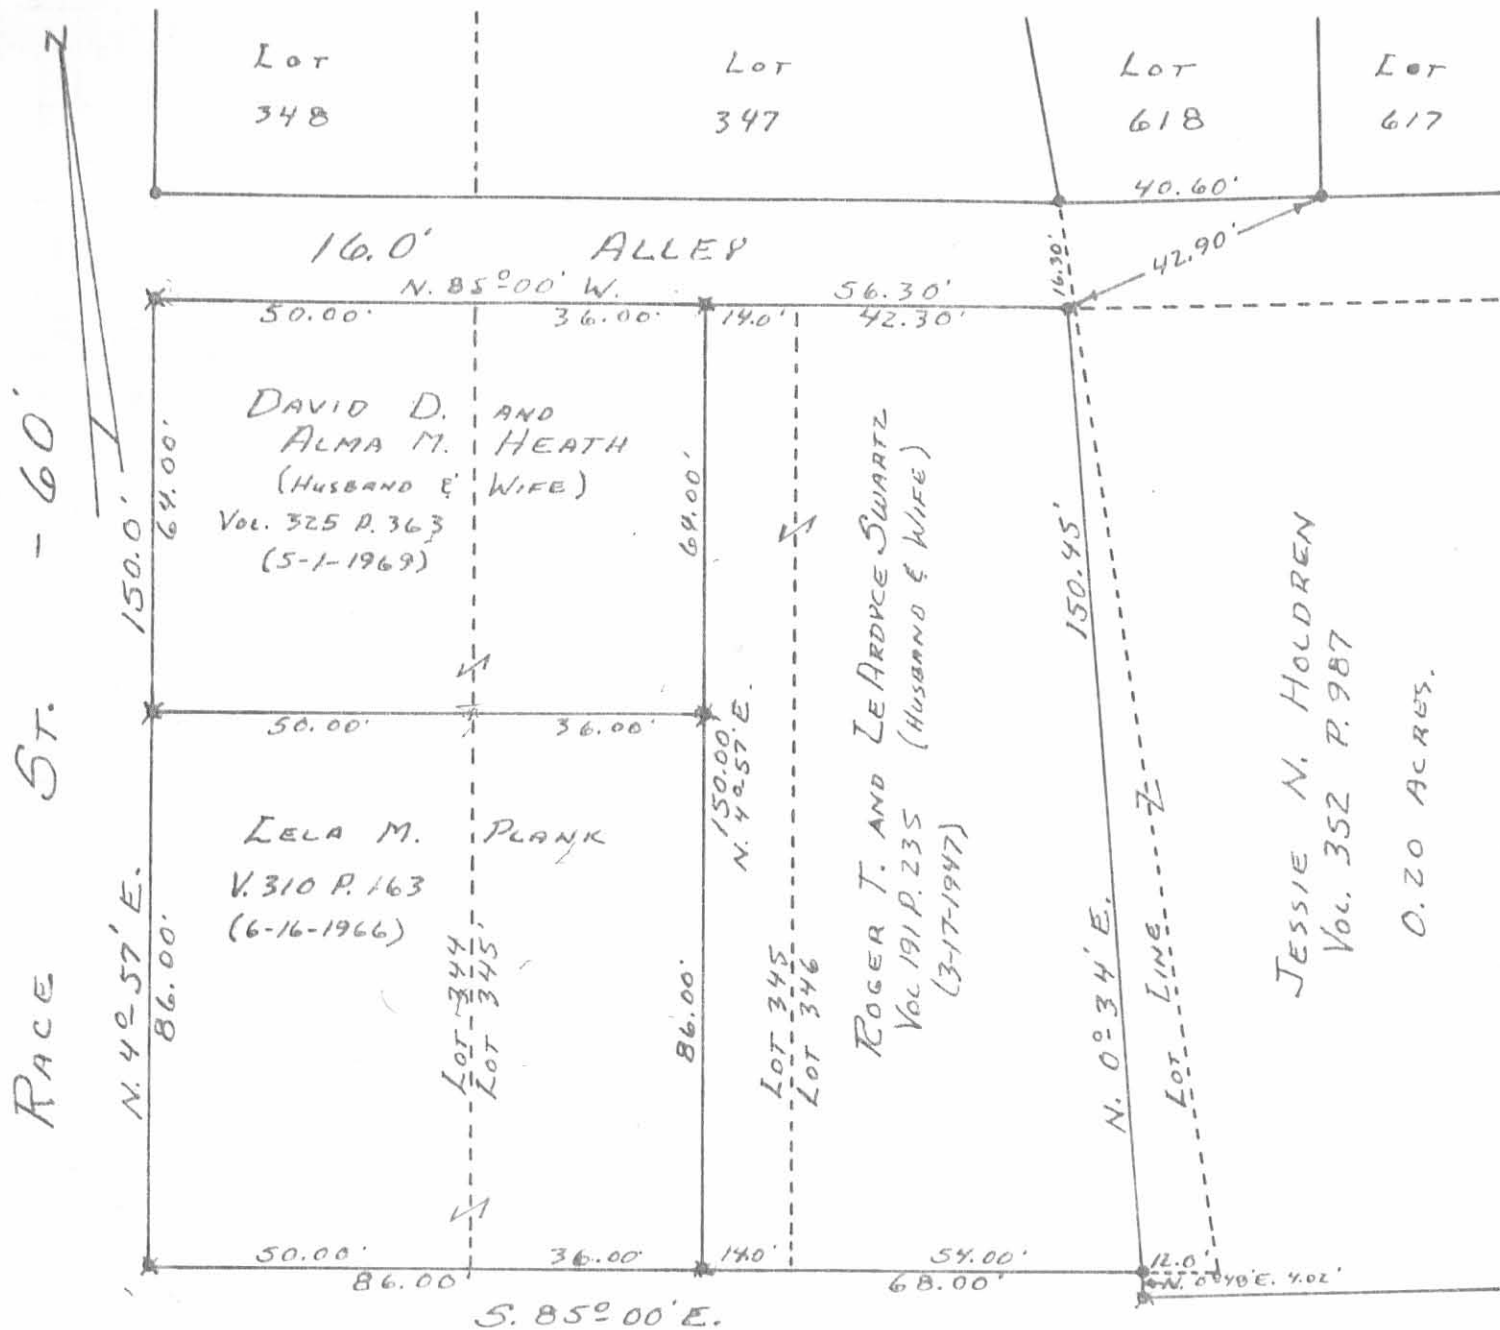

• - 5/8" IRON BARS FD. OR SET.  
 X - IRON PIPES FD.

3946 IP

INDEXED ON MAP

SURVEYED AND PLATED BY:  
 DANIEL E. GILBERT, P.S.  
 REG. SUR. NO. 5402

SWARTZ SURVEY  
 PART OF LOTS 345-346  
 SECTION 27, T. 5, R. 13 B.M.R.S.  
 VILLAGE OF WEST LIBERTY  
 LIBERTY TOWNSHIP  
 LOGAN COUNTY, OHIO  
 APRIL 25, 1981