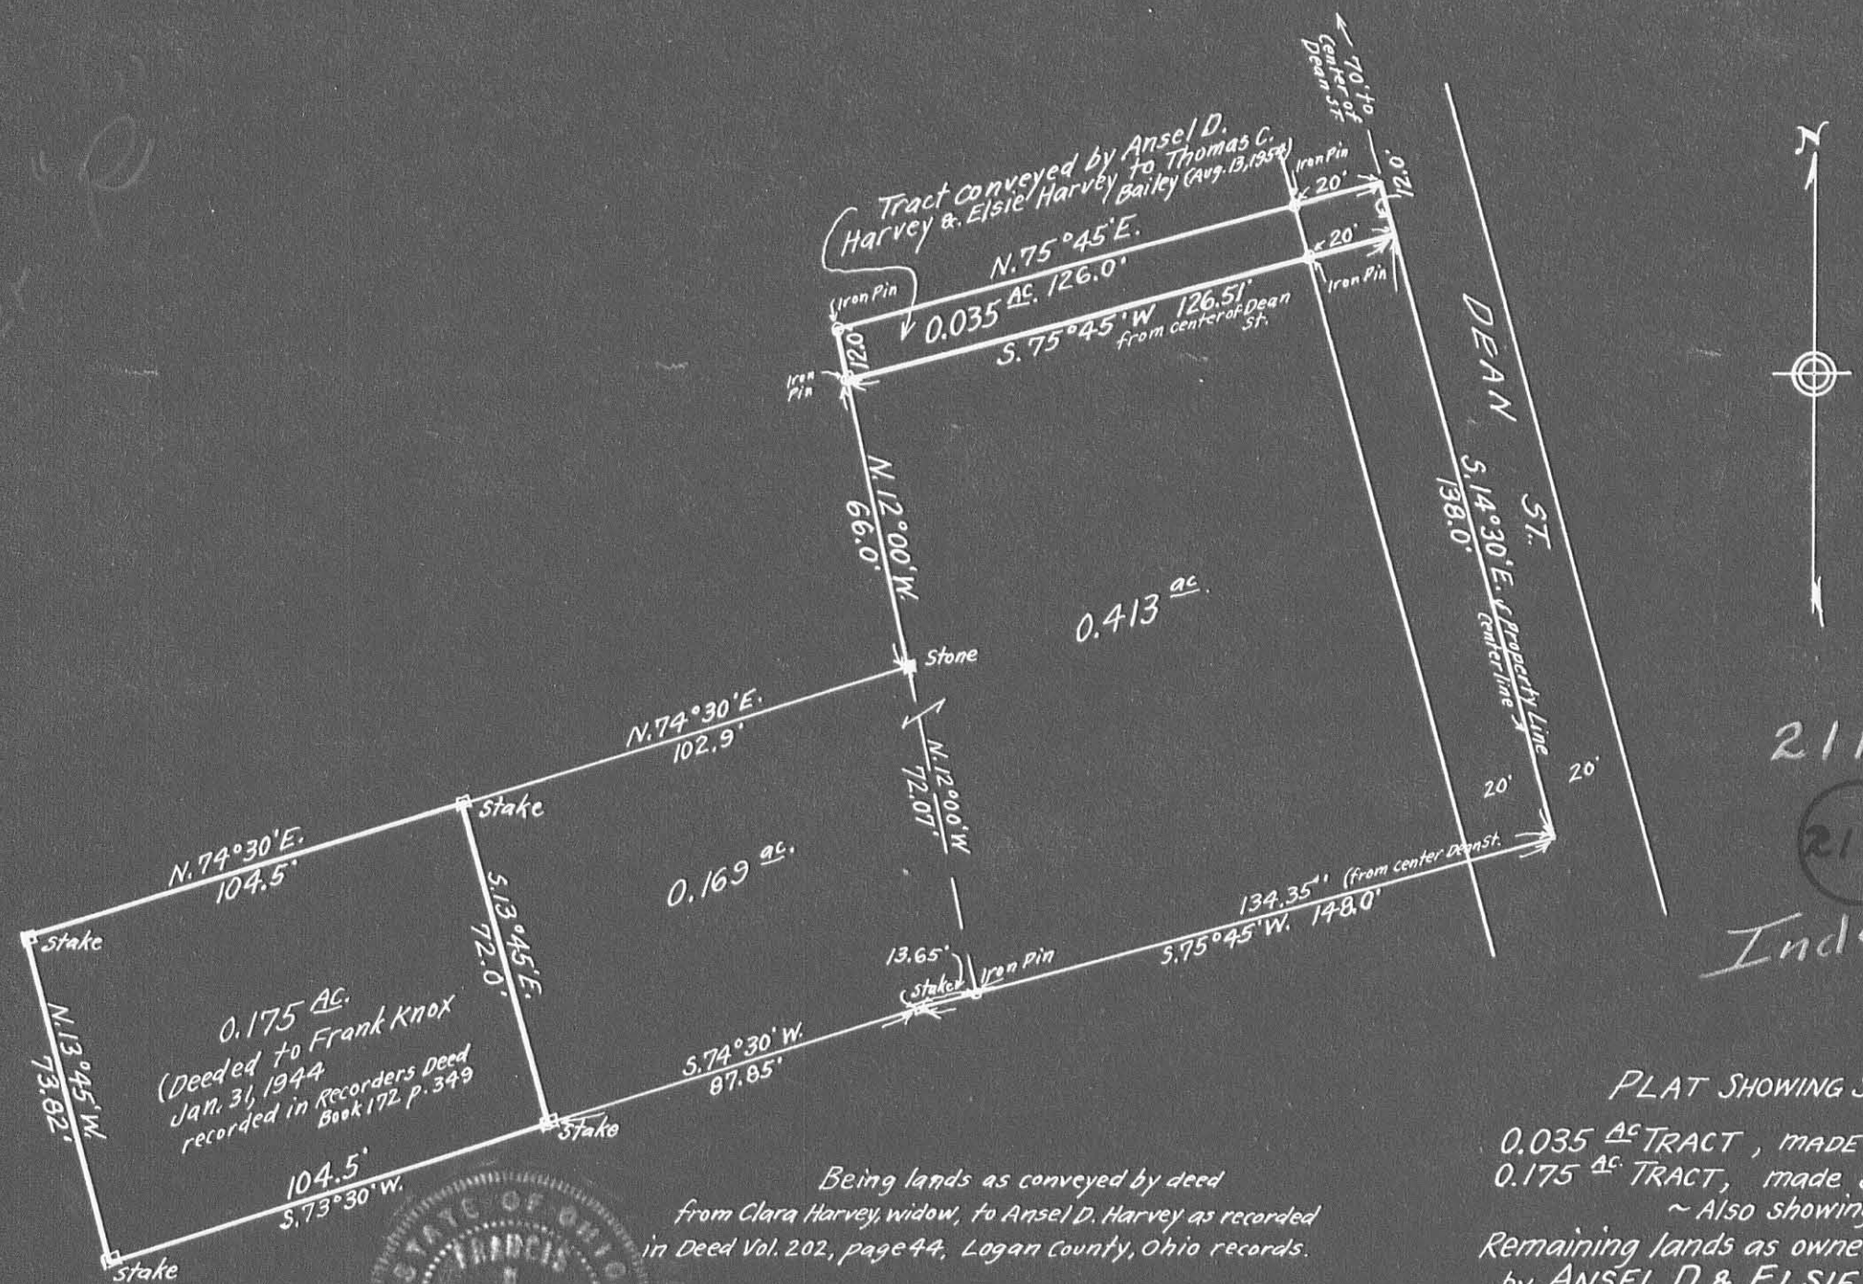

2119

(2119) IP

Indexed

Being lands as conveyed by deed from Clara Harvey, widow, to Ansel D. Harvey as recorded in Deed Vol. 202, page 44, Logan County, Ohio records.

STATE OF OHIO FRANCIS K. HARVEY 2570 REGISTERED SURVEYOR

F. K. Harvey
Registered Engineer & Surveyor

PLAT SHOWING SURVEYS OF

0.035 Ac TRACT, made Oct. 9, 1954
0.175 Ac. TRACT, made Sept. 18, 1943
~ Also showing ~
Remaining lands as owned (as of Oct. 9, 1954)
by ANSEL D. & ELSIE HARVEY

SITUATED IN VILLAGE OF
WEST MANSFIELD, OHIO - LOGAN CO.
VIRGINIA MILITARY SURVEYS NO. 755 & 6155
SCALE; 1" = 40