Middleburg Recreational Field

FB 685

See F.B. 558 page 11 for R
of S.R. 607 Route 278

See Drawer E for tracing

Party M. Hand
N. Keysor
D. Dodson

March 1949
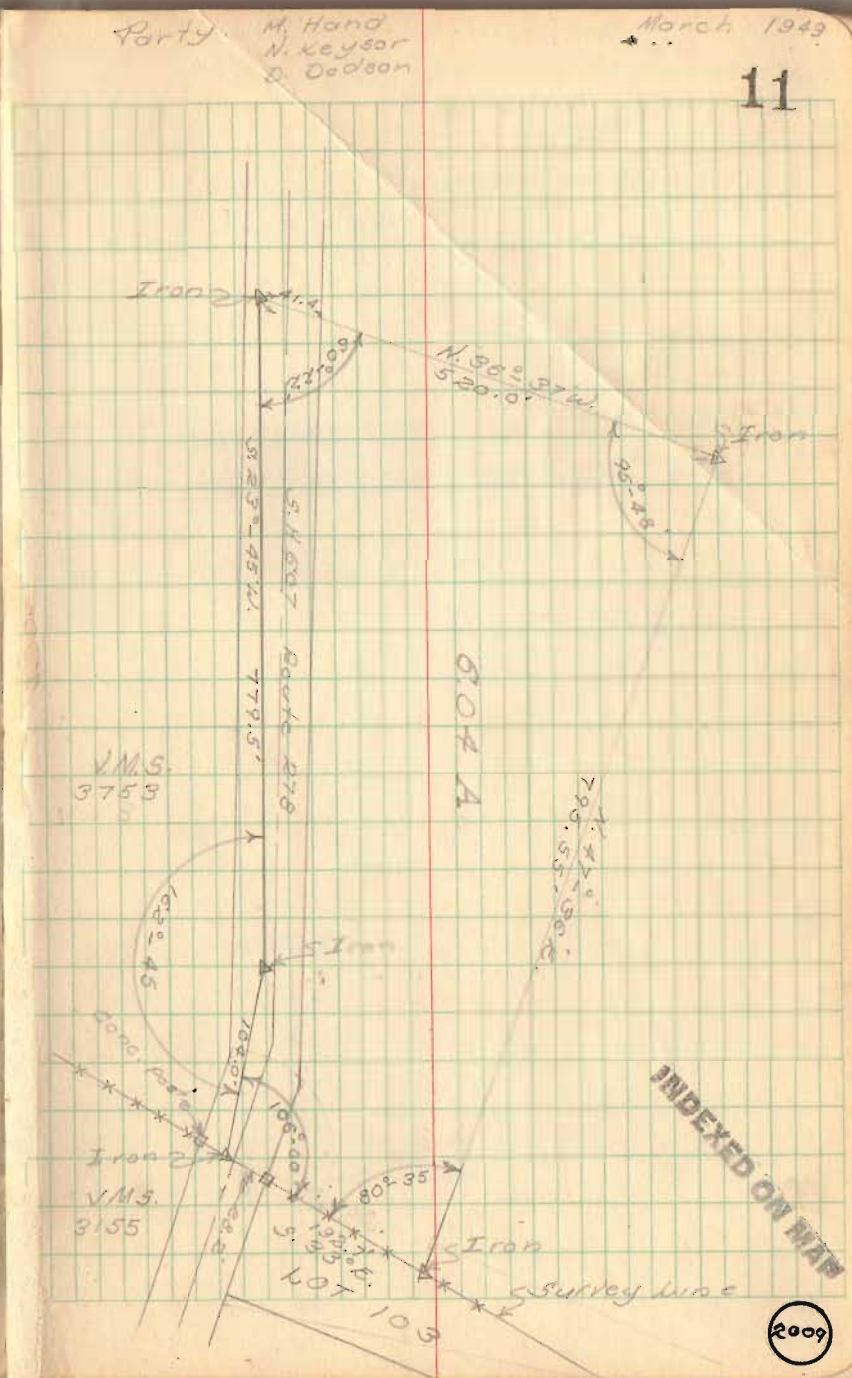
11