


SURVEY FOR CHURCH OF CHRIST  
 VILLAGE OF MIDDLEBURG, OHIO  
 LOGAN COUNTY

LOT 84 OF ADDITION TO  
 WEST MIDDLEBURG AS  
 RECORDED IN PLAT BOOK B,  
 PAGE 24

SCALE 1" = 50'  
 DATE 7-28-80

- Railroad Spike Set
- Iron Pin Set

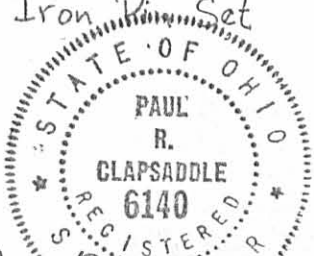

7153 IP

INDEXED ON MAP

LAND SURVEYING AND CIVIL ENGINEERING



PAUL R. CLAPSADDLE & ASSOCIATES  
 PROFESSIONAL LAND SURVEYORS  
 PROFESSIONAL ENGINEERS

19019 W. DARBY RD. P. O. BOX 184  
 MARYSVILLE, OHIO 43040 EAST LIBERTY, OHIO 43319  
 (513) 747-2599 (513) 666-2424

ATTEST: *Paul R. Clapsaddle*  
 P.S. # 6140