

LOGAN COUNTY
LAKE TOWNSHIP

BELLEFONTAINE
OHIO

THIS PROPERTY WAS RECORDED WITH
THE NEW YORK CENTRAL
RAILROAD COMPANY
JUNE 20, 1922
ANNOUNCED IN L.C. & DISTRICT NO. 17700
RECORDED DECEMBER 16, 1922

THE TOLEDO AND OHIO CENTRAL RAILWAY
RIGHT OF WAY AND TRACK MAP
OPERATED BY
ST. MARYS BRANCH -- MAIN LINE
FROM STATION 899+82 TO STATION 936+71.9
SCALE 1 INCH = 200 FEET
JUNE 30, 1918

DATE	DESCRIPTION	BY

1-303
10
R-48

Match Mark



LOGAN COUNTY
LAKE TOWNSHIP

BELLEFONTAINE
OHIO.

Sec. 35, T. 4, R. 14, M. R. S.
Sec. 34, T. 4, R. 14, M. R. S.

DEED RECORDS, 4th District (cont.)
 Vol. 2, Page 100
 1919
 1920
THIS PROPERTY WAS DECEDED WITH
 THE NEW YORK CENTRAL
 RAILROAD COMPANY
 JUNE 30, 1932
 AUTHORIZED IN L. C. DECREE NO. 17700
 DATED JUNE 18, 1932

RIGHT OF WAY AND TRACK MAP
 OF THE
 TOLEDO AND OHIO CENTRAL RAILWAY
 OPERATED BY
 THE TOLEDO AND OHIO CENTRAL RAILWAY COMPANY

ST. MARY'S BRANCH - MAIN LINE
 FROM STATION 966+71.9 TO STATION 1050+00
 SCALE 1 INCH = 100 FEET
 JUNE 30, 1918

SHEET NO. 12 OF 25
 ST. MARY'S BRANCH - MAIN LINE
 FROM STATION 966+71.9 TO STATION 1050+00
 SCALE 1 INCH = 100 FEET
 JUNE 30, 1918


11-3
 V-303
 11
 V-3
 11

Hannah Robinson.

Elizabeth Bash.
(Sallie Bash.)

Edward Houtz.

BELLEFONTAINE
OHIO

 

Br. #209
1103+51 C.I.Pipe 12"x30"

Match Mark 1
Fence ends
1099+43
Fence ends
1099+80
1-16 Form gate
Match Mark

1082+78 Br. No. 206
32' of 12" Cor. I. Pipe

5.87 Ac.
1081+92
1082+00
R.R. Iron

Br. #205
1078+58 Vit. Pipe 18"x48"
1078+58 Vit. Pipe 12"x4"

Michael Cartwell
 $\Delta = 3^{\circ}21'$
 $D = 0^{\circ}34'47''$
 $R = 10,111.02'$
 $T = 295.67'$

$\Delta = 9^{\circ}21'$
 $R = 335.59'$
 $T = 675.55'$

Br. #201
1060+50
Open Drain Timber
52 C.F. 5 in.
1060+50
Fence begins

LAKE TOWNSHIP
Sec. 35, T4 R4 M.R.S.
ST. TROY
Sec. 13, R14 M.R.S.
HARRISON TOWNSHIP

Year	Description	Station	Change

THE PROPERTY WAS RECORDED WITH
THE NEW YORK CENTRAL
RAILROAD COMPANY
JUNE 30, 1932
APPROVED BY L. C. DICKET NO. 7720
DECEMBER 18, 1932

RIGHT OF WAY AND TRACK MAP
OPERATED BY
THE TOLEDO AND OHIO CENTRAL RAILWAY COMPANY

ST. MARYS BRANCH -- MAIN LINE
FROM STATION 1050+00 TO STATION 1099+45
SCALE 1 INCH = 100 FEET
JUNE 30, 1918

THE TOLEDO AND OHIO CENTRAL RAILWAY COMPANY

LOGAN COUNTY
LAKE TOWNSHIP
HARRISON TOWNSHIP


SHEET NO. 13
FROM SURVEY STATION 1050+00 TO STATION 1099+45

W. J. HARRISON
VALUATION ENGINEER

V-303
12

12

1918 No Change
1919 No Change
1920 No Change
1921 No Change
1922 No Change
1923 No Change
1924 No Change
1925 No Change
1926 No Change
1927 No Change
1928 No Change
1929 No Change
1930 No Change

 

LOGAN COUNTY
HARRISON TOWNSHIP

THE TOLEDO AND OHIO CENTRAL RAILWAY
VALUATION ENGINEERS


THE TOLEDO AND OHIO CENTRAL RAILWAY COMPANY
THE TOLEDO AND OHIO CENTRAL RAILWAY
OPERATED BY
ST. MARYS BRANCH -- MAIN LINE
FROM STATION 1099+45 TO STATION 1196+33.7
SCALE 1 INCH = 200 FEET
JUNE 30, 1918

THIS PROPERTY WAS MERGED WITH
THE NEW YORK CENTRAL
RAILROAD COMPANY
JUNE 30, 1912
AUTHORIZED BY U.S. DISTRICT COURT, CLEVELAND, OHIO
DECEMBER 18, 1907

RIGHT OF WAY AND TRACK MAP

REVISION	DATE	BY	DESCRIPTION

W.B. 13
13

 

LOGAN COUNTY
HARRISON TOWNSHIP

THE TOLEDO AND OHIO CENTRAL RAILWAY COMPANY

OPERATED BY
THE TOLEDO AND OHIO CENTRAL RAILWAY

RIGHT OF WAY AND TRACK MAP

ANNOUNCED IN L. C. ORDER NO. 17700
DECEMBER 18, 1932

ST. MARYS BRANCH -- MAIN LINE
FROM STATION 1196+33.7 TO STATION 1306+13.5

SCALE 1 INCH = 200 FEET
JUNE 30, 1918

OFFICE OF VALUATION ENGINEER, COLUMBUS, OHIO

OFFICE OF ENGINEER, COLUMBUS, OHIO

THE PROPERTY WAS HELD BY
THE NEW YORK CENTRAL
RAILROAD COMPANY

JUNE 30, 1912

Year	Description	Stationing
1897	McChange	1249
1898	McChange	1249
V-303
14

1/3

1/4

1/4

 

LOGAN COUNTY
HARRISON TOWNSHIP
WASHINGTON TOWNSHIP

THE TOLEDO AND OHIO CENTRAL RAILWAY COMPANY


ST. MARYS BRANCH -- MAIN LINE
FROM STATION 1306+13.5 TO STATION 1400+88.5
OFFICE OF VALUATOR, ENGINEER, COLUMBUS, OHIO
JUNE 30, 1918

APPROVED IN L.C. ORDER NO. 17700
DECEMBER 18, 1902

THIS PROPERTY WAS MERGED WITH THE NEW YORK CENTRAL RAILROAD COMPANY

Year	Change	Year	Change

Sheet No. 15 of 35
ST. MARYS BRANCH - MAIN LINE
FROM STATION 1306+13.5 TO STATION 1400+88.5
OFFICE OF VALUATOR, ENGINEER, COLUMBUS, OHIO
JUNE 30, 1918

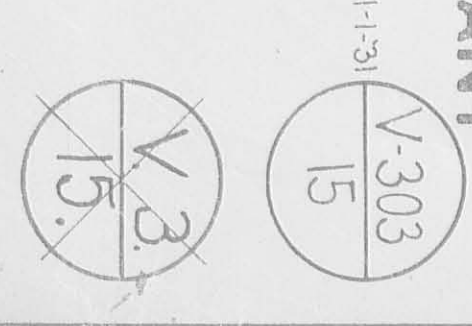

LOGAN COUNTY
WASHINGTON TOWNSHIP



1:30
V-303
16

THE TOLEDO AND OHIO CENTRAL RAILWAY COMPANY
OPERATED BY
THE TOLEDO AND OHIO CENTRAL RAILWAY
ST. MARYS BRANCH -- MAIN LINE
FROM STATION 1400+00 TO STATION 1500+00
SCALE 1 INCH = 200 FEET
OFFICE OF VALUATION ENGINEER, COLUMBUS, OHIO
JUNE 30, 1918

RIGHT OF WAY AND TRACK MAP
ANNEXMENT N.L. & DIRECT NO. 1770
RECORDED JUNE 11, 1927

THE TOLEDO AND OHIO CENTRAL RAILWAY
OPERATED BY
THE TOLEDO AND OHIO CENTRAL RAILWAY
ST. MARYS BRANCH -- MAIN LINE
FROM STATION 1400+00 TO STATION 1500+00
SCALE 1 INCH = 200 FEET
OFFICE OF VALUATION ENGINEER, COLUMBUS, OHIO
JUNE 30, 1918

303
18

 

THE TOLEDO AND OHIO CENTRAL RAILWAY COMPANY


ST. MARYS BRANCH -- MAIN LINE
FROM STATION 1500+00 TO STATION 1900+00
SCALE 1" INCH = 200 FEET
OFFICE OF VALUATION ENGINEERS, COLUMBUS, OHIO
JUNE 30, 1918


RIGHT OF WAY AND TRACK MAP
THE TOLEDO AND OHIO CENTRAL RAILWAY

OPERATED BY
THE PROPERTY WAS RECORDED WITH
THE NEW YORK CENTRAL
RAILROAD COMPANY
JUNE 30, 1912
ANTHONY W.L. & C. CORP. INC. 1770
DECEMBER 18, 1932

Station	Description	Year	Notes
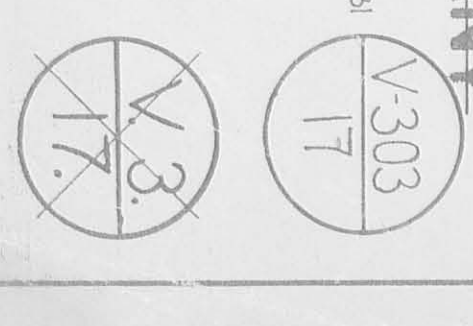

 

LOGAN COUNTY
WASHINGTON TOWNSHIP
STOKES TOWNSHIP

THE TOLEDO AND OHIO CENTRAL RAILWAY COMPANY
ST. MARYS BRANCH -- MAIN LINE
FROM STATION 1600+00 TO STATION 1700+35.2
SCALE 1 INCH = 200 FEET
JUNE 30 1918

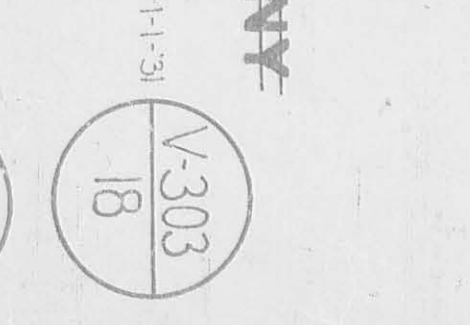

THIS PROPERTY WAS RECORDED WITH
THE NEW YORK CENTRAL
RAILROAD COMPANY
JUNE 30 1918
ANNOUNCED IN C. C. BOARDING NO. 17709
OCTOBER 18 1912

Station	Notes
1918	McChange
1919	McChange
1918 6-1-18
1919 6-1-18
Thomas Wallace.

Thomas Houchins
(Wm Rose)

Ed. Houchins.
(Frank Houchins)

S.M. Howell
(Claude Bailey)

Geo. W. Mc Millen
(Claude Bailey)

R.J. Morris.
(Luther Black)

Wm D. Jervis.
(Geo. Ryder)

LAKE VIEW
OHIO.

RESERVOIR

Br. #341
1/2" Pipe, 12" x 26', 1800+01.
Cl. Pipe, 18" x 24', 1799+52.1

Br. #338
1/2" Pipe, 12" x 30', 1753+32.
1/2" Pipe, 18" x 18" Overflow

Br. #334, part of County, Ohio
1/2" Pipe, 24" x 40', 1762+16.
1/2" Pipe, 18" x 40', 1761+34.
Br. #333

Br. #329
1/2" Pipe, 10' x 30', 1736+105.

Br. #327
1/2" Pipe, 18' x 30', 1726+86.

1726+86. Wm. D. Couplins.

Br. #325, Timber Trestle, 7' x 4'
10' span, 36' long
4 Pile Beets

Mrs. L. C. Pugh, 330'
10' span, 36' long
4 Pile Beets

W. G. Walters
1700+36.2

Match Mark 1
1796+69

1-16 Farm gate 1791+25

Iron 1779+5246

1773+84 2-16 Farm gates

1769+098


Iron 1759+5292

1755+553

1-16 Farm gate 1746+17

1744+70

1739+295

1729+220.9

1724+53 Fence begins

Iron 1719+5939

1714+13 Fence ends

1708+18 Fence ends

1706+95.6 P.S. (592)

1704+96 Br. #325, Timber Trestle, 7' x 4'
10' span, 36' long
4 Pile Beets

1700+36.2

1697+68

Match Mark 7

LOGAN COUNTY
STOKES TOWNSHIP

THE TOLEDO AND OHIO CENTRAL RAILWAY COMPANY

RIGHT OF WAY AND TRACK MAP

OPERATED BY

THE NEW YORK CENTRAL
RAILROAD COMPANY

ST. MARYS BRANCH -- MAIN LINE

FROM STATION 1700+95-2 TO STATION 1796+69

SCALE 1 INCH = 200 FEET

JUNE 30, 1916

OFFICE OF VALUATION ENGINEER, COLUMBUS, OHIO

STATION ENGINEER

DATE

1916

1916

V.303

V.303

SANTA FE
OHIO.

LOGAN CO. STOKES TWP.
Sec. 30, T.6S, R.8E.
Sec. 25, T.6S, R.7E.
AUGLAIZE CO. CLAY TWP.

AUGLAIZE COUNTY
CLAY TOWNSHIP

LOGAN COUNTY
STOKES TOWNSHIP


THIS PROPERTY WAS MERGED WITH
THE NEW YORK CENTRAL
RAILROAD COMPANY

JUNE 30, 1932
AUTHORIZED IN U.S.C. SOCKET NO. 17700
RECORDED JUNE 18, 1932

RIGHT OF WAY AND TRACK MAP

THE TOLEDO AND OHIO CENTRAL RAILWAY COMPANY
OPERATED BY

ST. MARYS BRANCH -- MAIN LINE
FROM STATION 1900+00 TO STATION 2000+38.
SCALE 1 INCH = 200 FEET
JUNE 30, 1918

OFFICE OF VALUATION ENGINEER, COLUMBUS, OHIO
CORRECTED AS OF JAN. 1, 1931
OFFICE OF VALUATION ENGINEER, CLEVELAND, OHIO
CORRECTED AS OF JAN. 1, 1931

Auglaize Co. Clay Twp.
Stokes Twp. Logan Co.


