8-30-88

Note:

A New dedication Plat
For Section 1.32 to 2.34
was recorded 8-30-88
signed by landowners except
James E. Fulton Etux.

60 Foot R/W

CR Kurtz

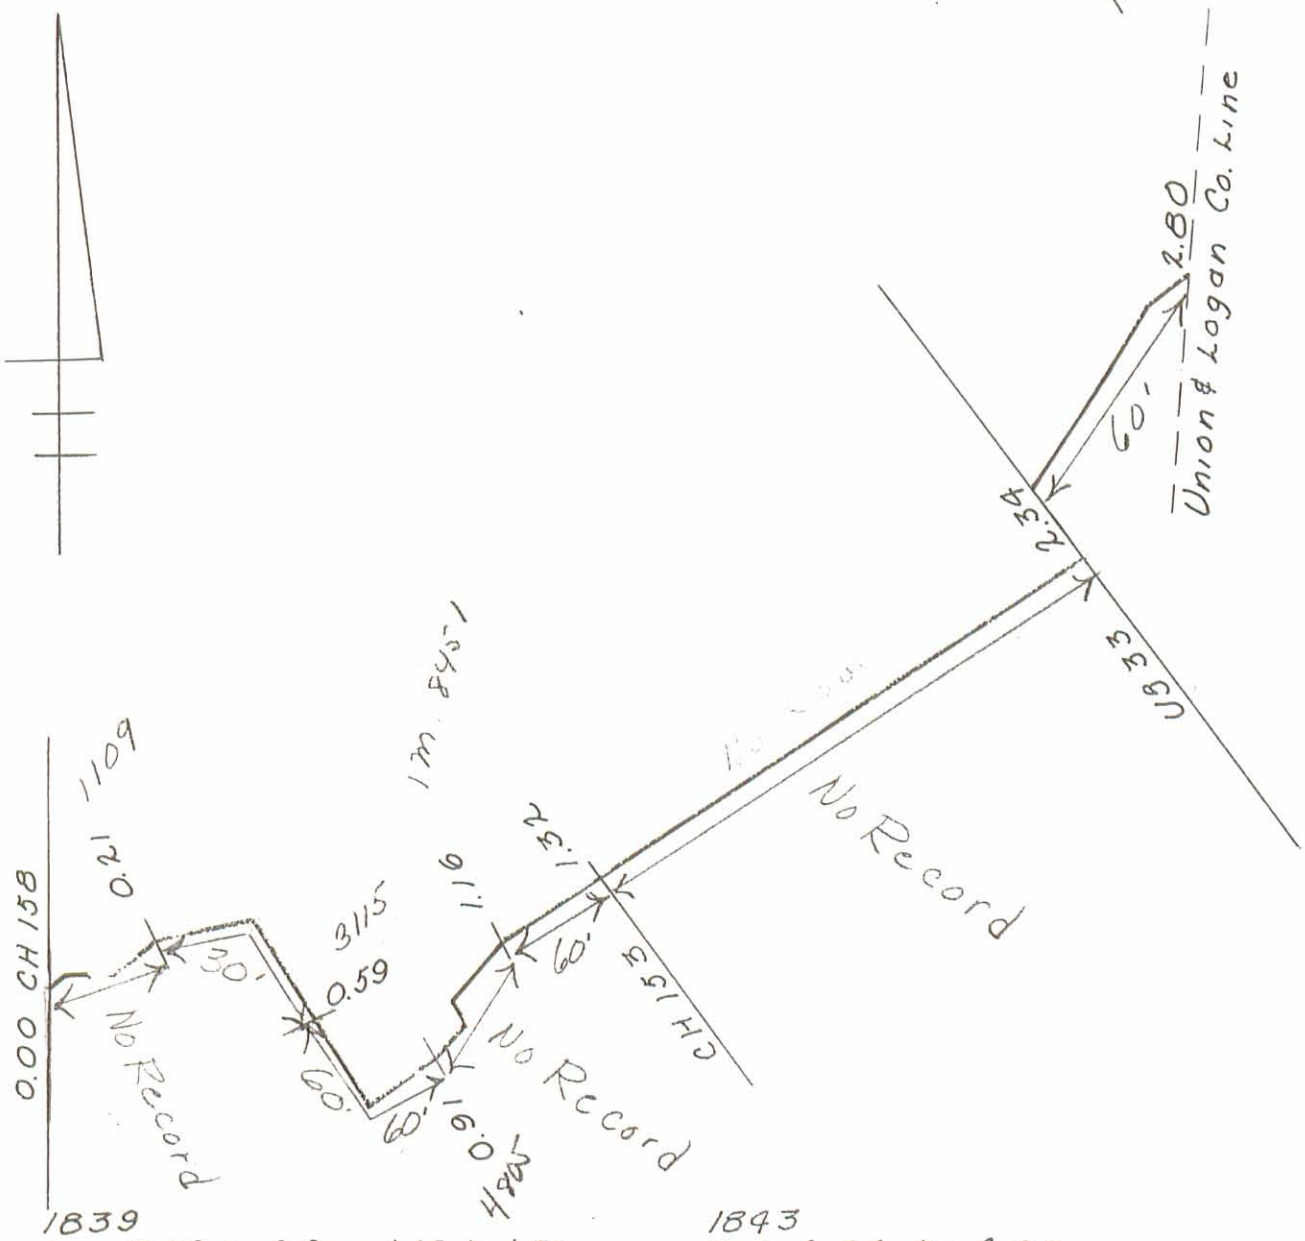

1839
Sec. 0.59 to 0.91 & 1.16 to 1.32
Com. Journal 6, Page 120
60' Right of way

1843
Sec. 2.34 to 2.80
Com. Journal 7, Page 122
60' Right of way

1861
Sec. 0.21 to 0.59
Road Record 1, Page 116
30' Right of Way

Road 157

Scale 3" = 1 Mi.