


TOPO SURVEY
 LOTS 113 - 114 Pt. - 88 Pt
 BELLEFONTAINE, OHIO
 FOR
 THE LIMA TELEPHONE COMPANY

MARCH 2, 1968
 SCALE 1" = 10'

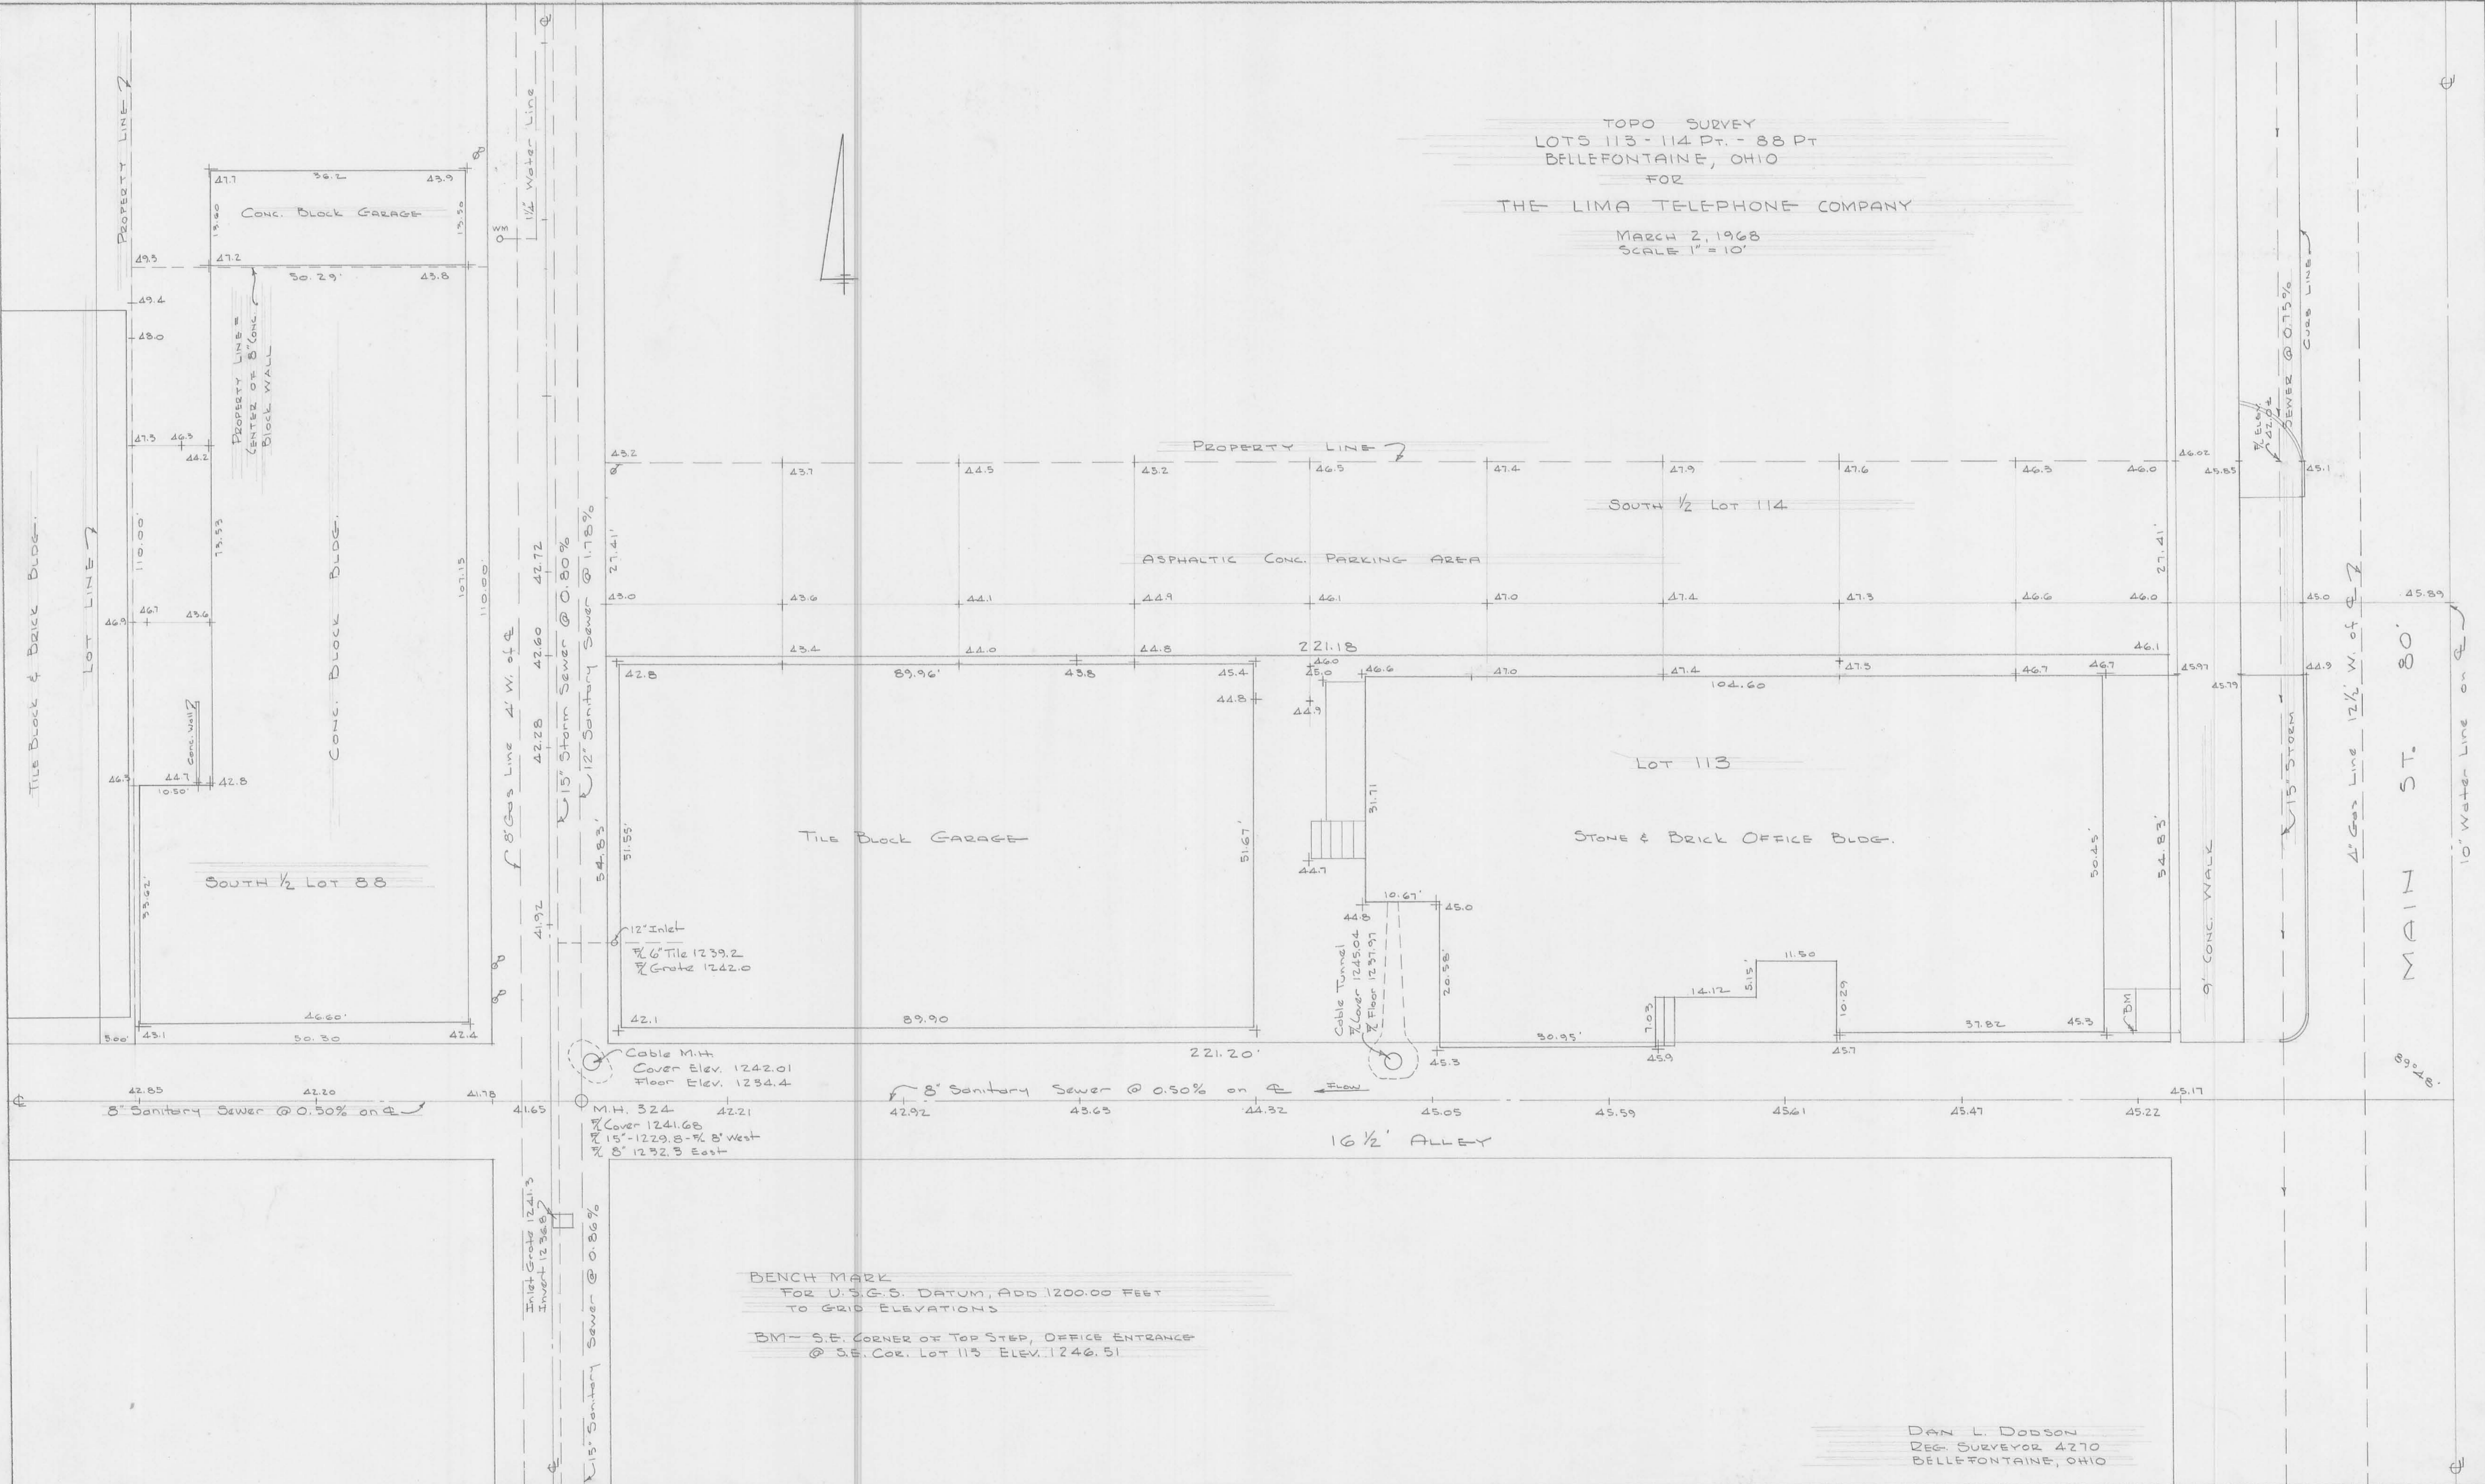

BENCH MARK
 FOR U.S.G.S. DATUM, ADD .1200.00 FEET
 TO GRID ELEVATIONS

BM - S.E. CORNER OF TOP STEP, OFFICE ENTRANCE
 @ S.E. COR. LOT 113 ELEV. 1246.51

DAN L. DODSON
 REG. SURVEYOR 4270
 BELLEFONTAINE, OHIO