W. SANDUSKY AVE.

N. DETROIT ST.

SURVEY OF PARTS OF LOTS 69, 76, 85 & 88 CITY OF BELLEFONTAINE SECTION 35 T.4 R.14 B.M.R.S. LAKE TOWNSHIP LOGAN COUNTY, OHIO JULY 1969

SCALE: 1" = 20'

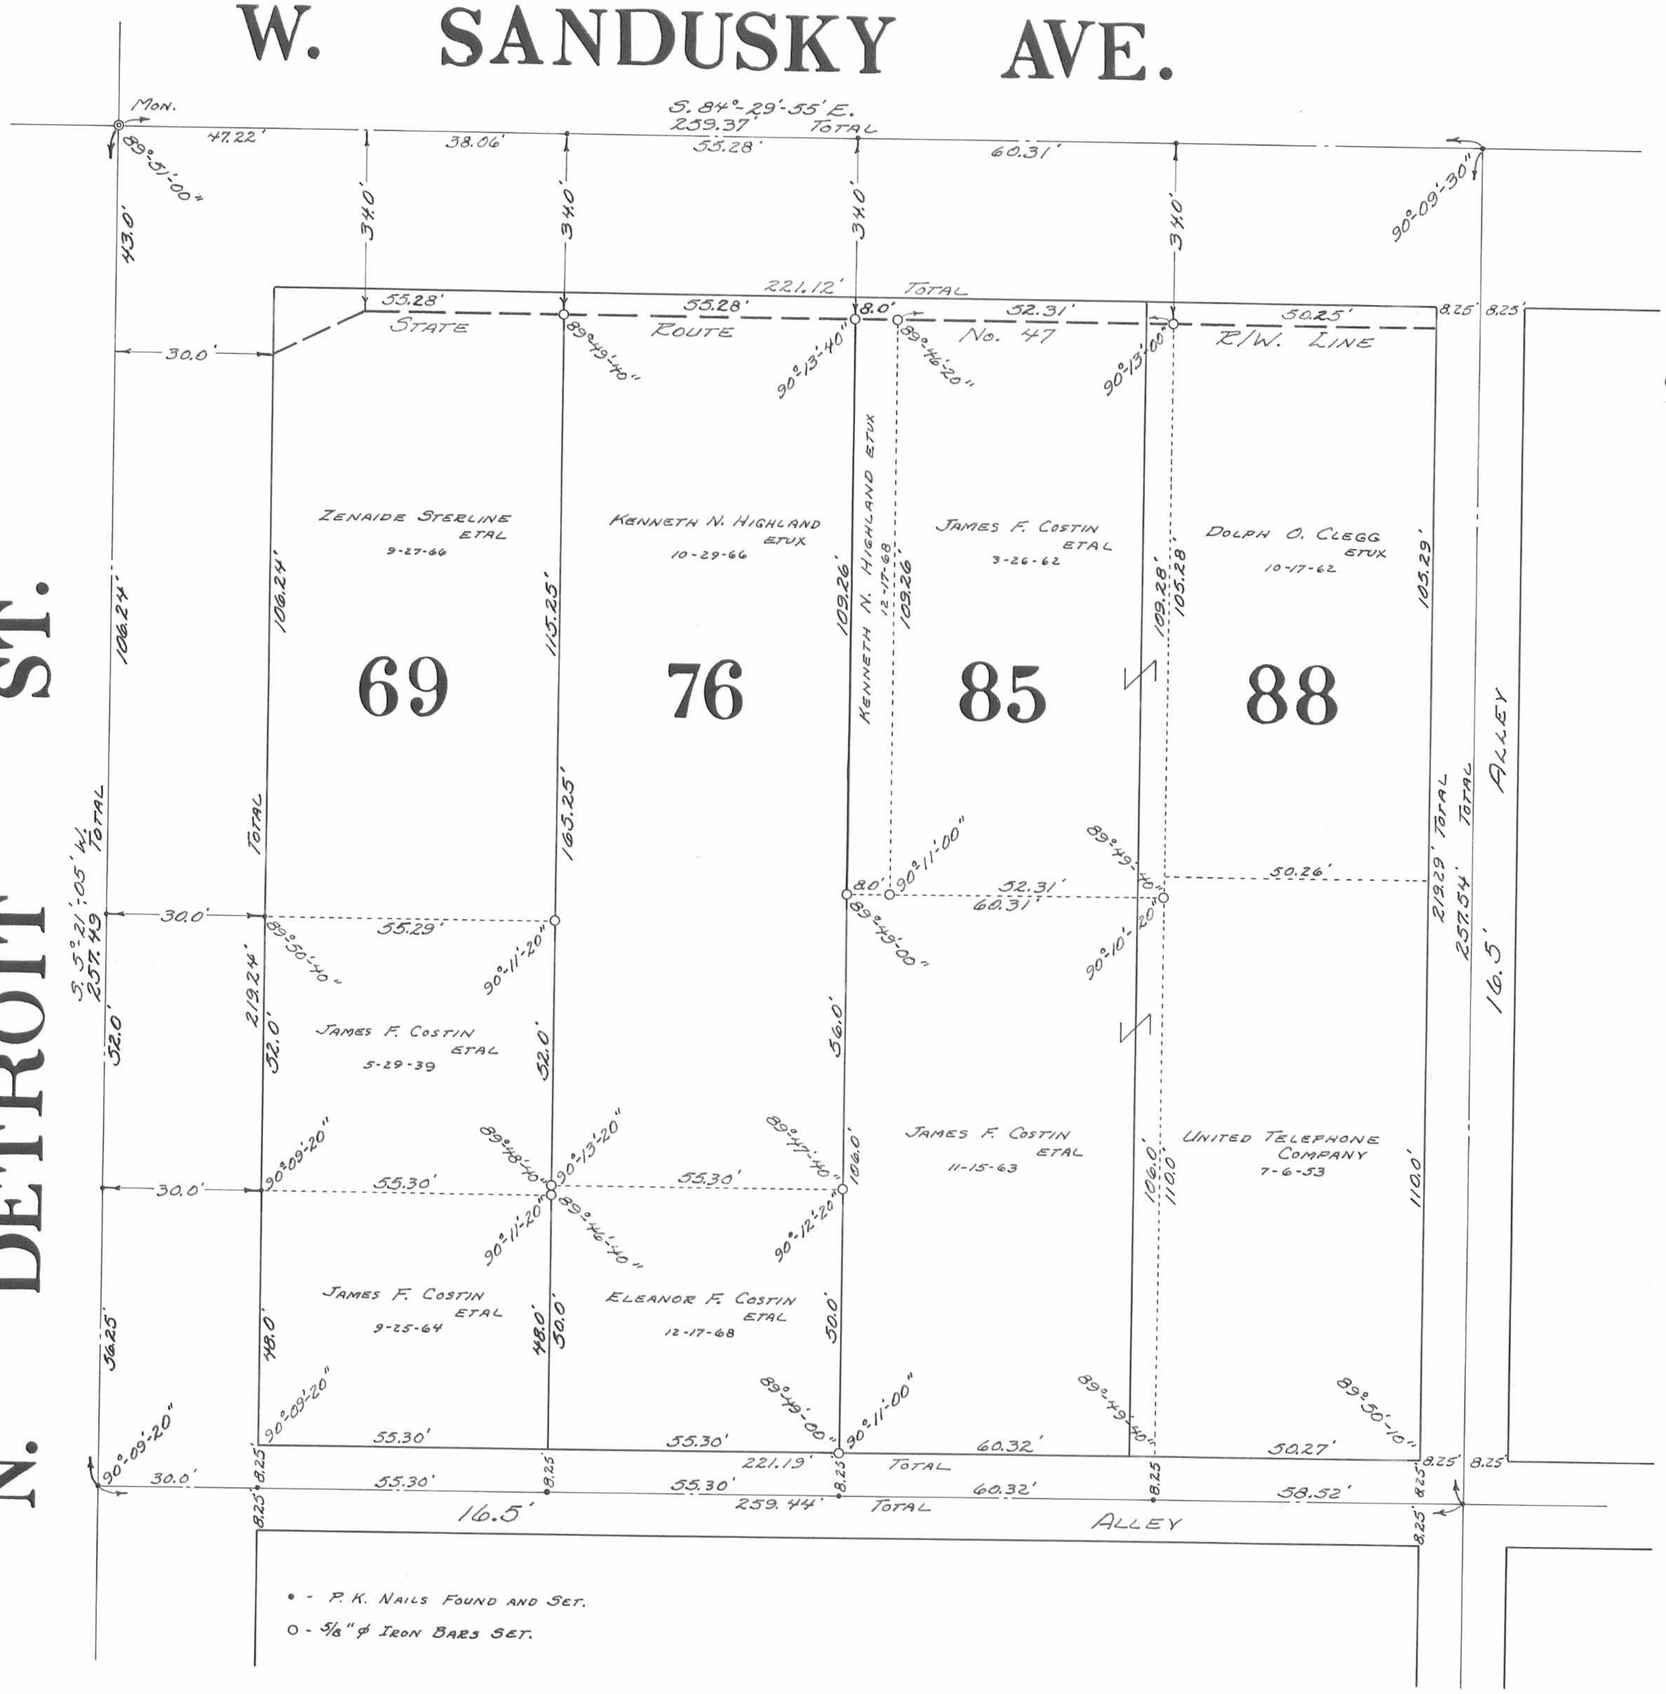

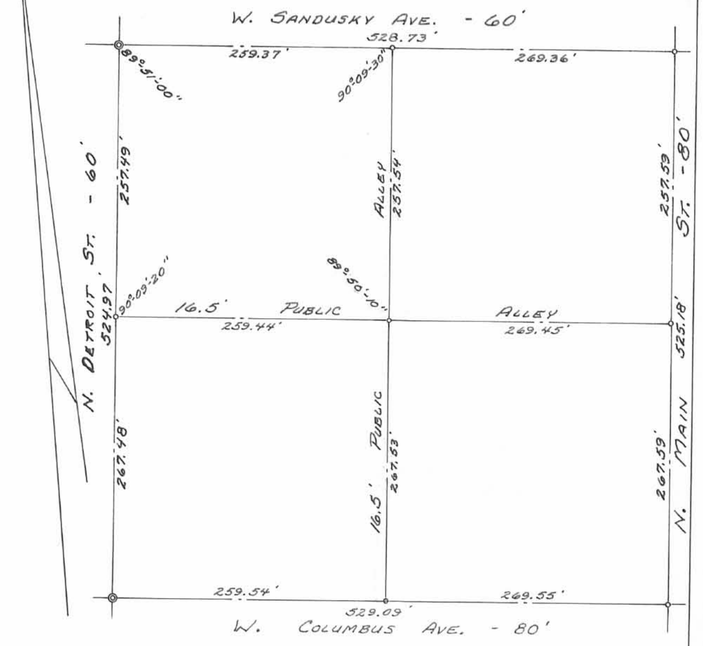

• - P.K. NAILS FOUND OR SET.
◎ - CITY MONUMENTS.

SCALE: 1"=100'

SURVEYED AND PLATTED BY:
DANIEL E. GILBERT, P.S.
REG. SUR. NO. 5402
428 N. MADRIVER ST.
BELLEFONTAINE, OHIO 43311

S-244

4572

S-244