Richland Township Survey

Richland Township
Village Of Belle Center
Logan County, Ohio
V.M.S. 9989
August 1998

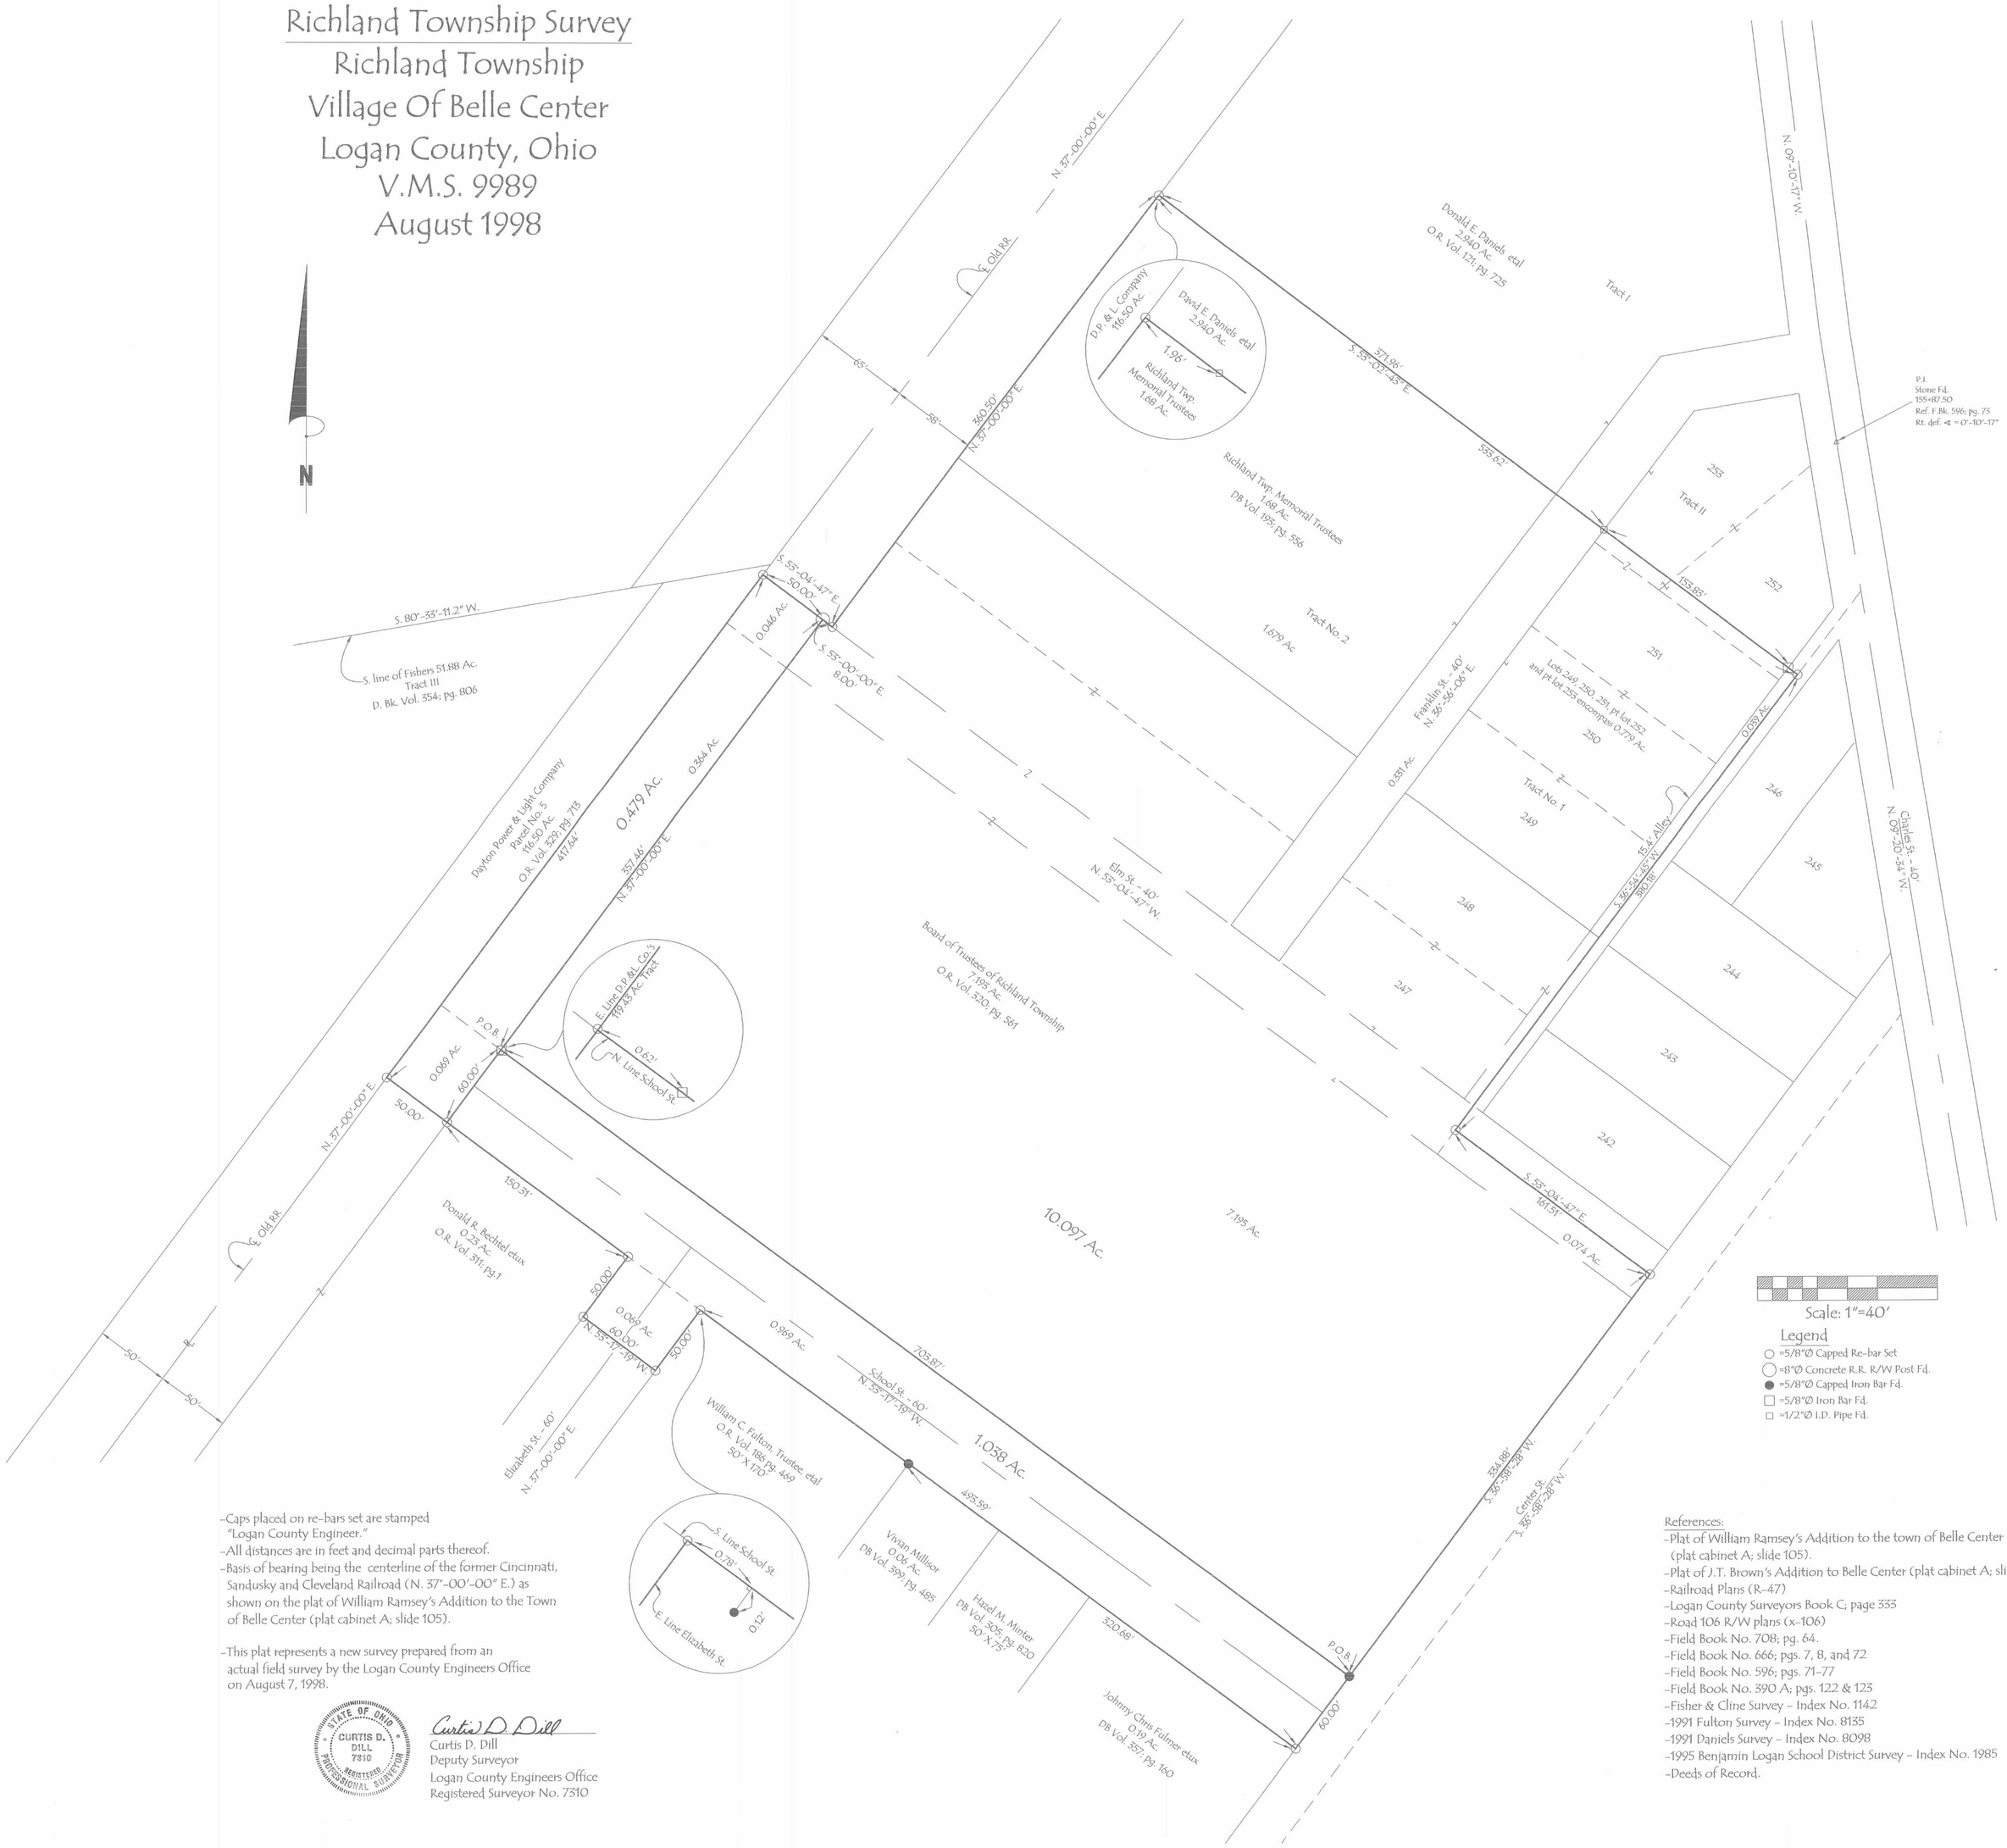

-Caps placed on re-bars set are stamped "Logan County Engineer."
-All distances are in feet and decimal parts thereof.
-Basis of bearing being the centerline of the former Cincinnati, Sandusky and Cleveland Railroad (N. 37°-00'-00" E.) as shown on the plat of William Ramsey's Addition to the Town of Belle Center (plat cabinet A; slide 105).

-This plat represents a new survey prepared from an actual field survey by the Logan County Engineers Office on August 7, 1998.

STATE OF OHIO
CURTIS D. DILL
7310
REGISTERED
PROFESSIONAL SURVEYOR

Curtis D. Dill
Curtis D. Dill
Deputy Surveyor
Logan County Engineers Office
Registered Surveyor No. 7310

References:
-Plat of William Ramsey's Addition to the town of Belle Center (plat cabinet A; slide 105).
-Plat of J.T. Brown's Addition to Belle Center (plat cabinet A; slide 63
-Railroad Plans (R-47)
-Logan County Surveyors Book C; page 333
-Road 106 R/W plans (x-106)
-Field Book No. 708; pg. 64.
-Field Book No. 666; pgs. 7, 8, and 72
-Field Book No. 596; pgs. 71-77
-Field Book No. 390 A; pgs. 122 & 123
-Fisher & Cline Survey - Index No. 1142
-1991 Fulton Survey - Index No. 8135
-1991 Daniels Survey - Index No. 8098
-1995 Benjamin Logan School District Survey - Index No. 1985
-Deeds of Record.

F:\PAUL\RICHLAND\RICH1.DWG Fri Apr 09 11:27:44 1999 J. Paul Trumbull College Intern
HP DesignJet 650C Hewlett-Packard HP-GL/2 devices, ADI 4.3 - for Autodesk by HP

S-314

S-314