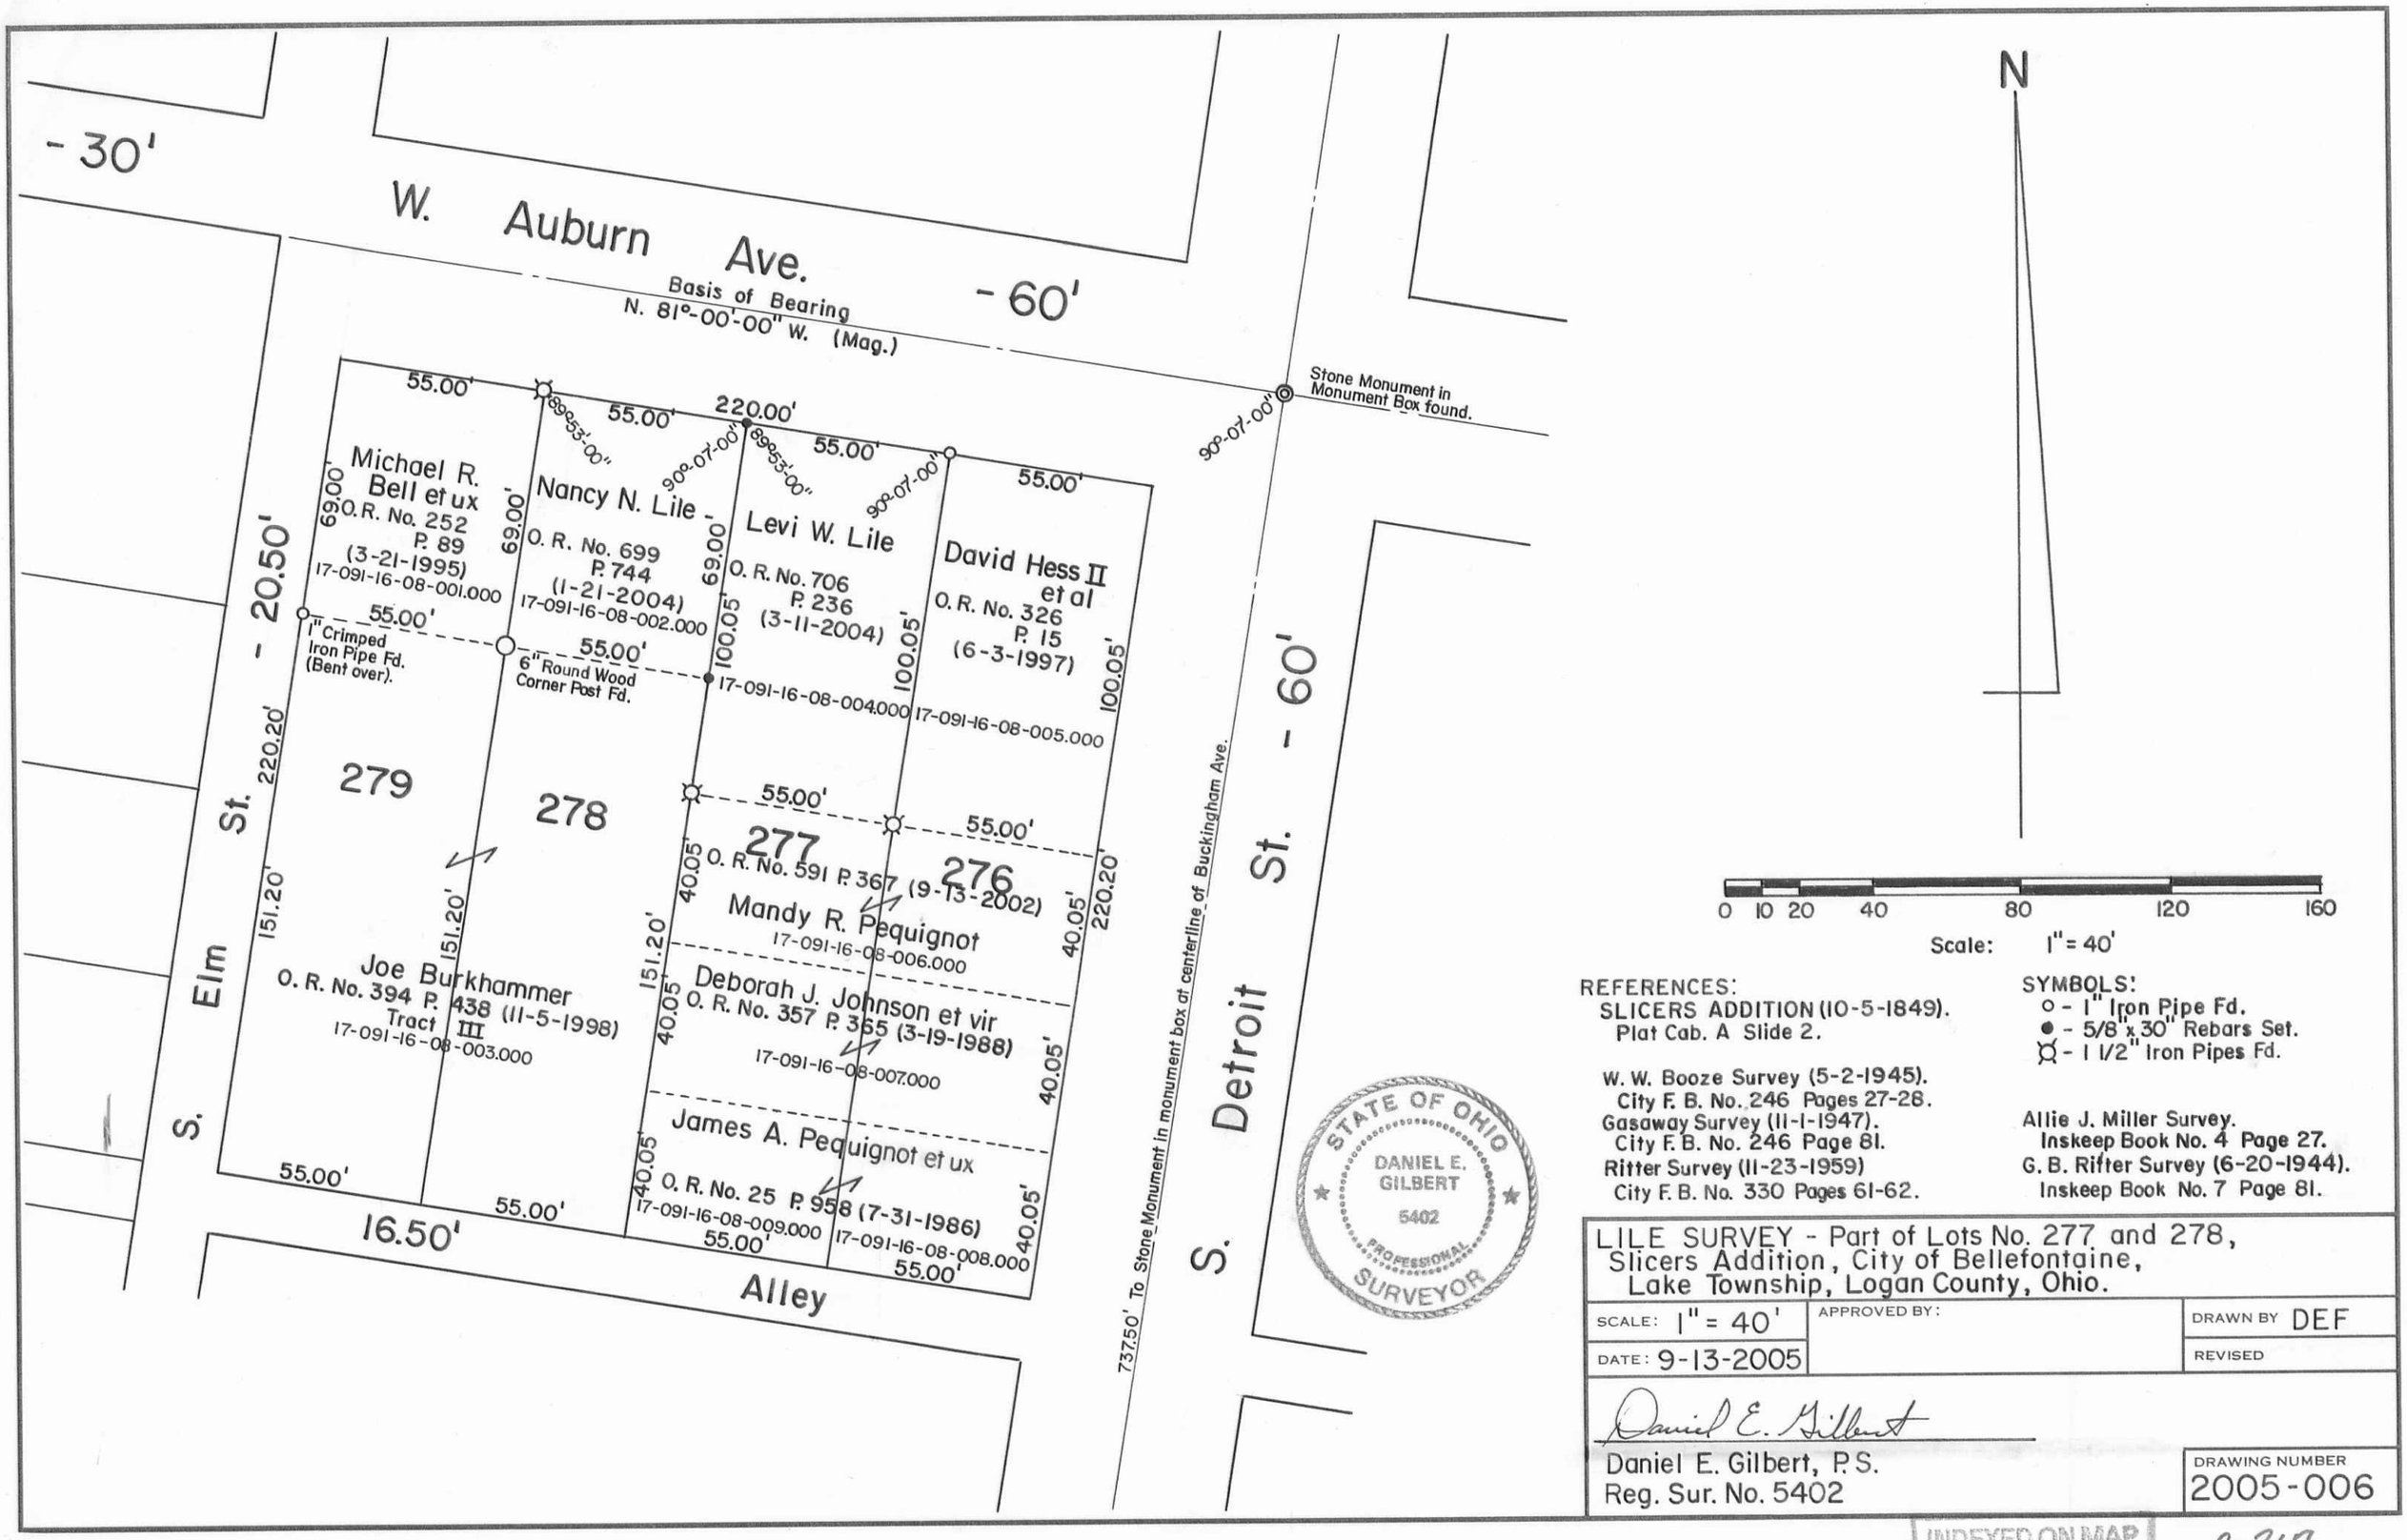

REFERENCES:
SLICERS ADDITION (10-5-1849).
Plat Cab. A Slide 2.

W. W. Booze Survey (5-2-1945).
City F. B. No. 246 Pages 27-28.
Gasaway Survey (11-1-1947).
City F. B. No. 246 Page 81.
Ritter Survey (11-23-1959)
City F. B. No. 330 Pages 61-62.

SYMBOLS:
○ - 1" Iron Pipe Fd.
● - 5/8"x30" Rebars Set.
⌘ - 1 1/2" Iron Pipes Fd.

Allie J. Miller Survey.
Inskeep Book No. 4 Page 27.
G. B. Ritter Survey (6-20-1944).
Inskeep Book No. 7 Page 81.

LILE SURVEY - Part of Lots No. 277 and 278,
Slicers Addition, City of Bellefontaine,
Lake Township, Logan County, Ohio.

SCALE: 1" = 40'	APPROVED BY:	DRAWN BY DEF
DATE: 9-13-2005		REVISED

Daniel E. Gilbert
Daniel E. Gilbert, P.S.
Reg. Sur. No. 5402

DRAWING NUMBER
2005-006

INDEXED ON MAP
2254

S-367