


Hickory Lane

29

28

27

26

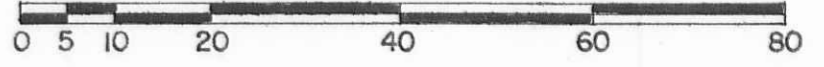

- SYMBOLS:
- ✕ - Drill Hole in Concrete Drive Fd.
 - - 5/8" Rebars Fd.
 - ⊙ - 5/8" Rebar in 1" Iron Pipe Fd.
 - ⊗ - 1" Iron Pipe Fd.
 - - 5/8" x 30" Rebars Set. (Capped).

REFERENCE:
 Lakeridge Subdivision No. 1 (7-1-1957).
 Plat Cab. A, Slides 353-355.

ReSurvey of Lot No. 27 and south side of Lot No. 28,
 Lakeridge Subdivision No. 1, V. M. S. No. 12276,
 Stokes Township, Logan County, Ohio.

SCALE: 1" = 20'	APPROVED BY:	DRAWN BY DEG
DATE 6-4-2004		REVISED

Daniel E. Gilbert
 Daniel E. Gilbert, P.S.
 Reg. Sur. No. 5402

DRAWING NUMBER
 2004-023

INDEXED ON MAP
 6633

S-375

