



Scale: 1" = 20'

- SYMBOLS:
- - Drill Hole in Concrete Drive Set.
 - o - 5/8" Rebars Fd.
 - ⊙ - 5/8" Rebar in 1" Iron Pipe Fd.
 - - 5/8" x 30" Rebar Set. (Capped).


REFERENCE:
Lakeridge Subdivision No. 1 (7-1-1957)
Plat Cab. A, Slides 353-355.

ReSurvey of Lot No. 28, Lakeridge Subdivision No. 1,
V. M.S. No. 12276, Stokes Township,
Logan County, Ohio.

SCALE: 1" = 20'	APPROVED BY:	DRAWN BY DEG
DATE: 10-17-2002		REVISED

Daniel E. Gilbert
Daniel E. Gilbert, P.S.
Reg. Sur. No. 5402

DRAWING NUMBER
2002-026

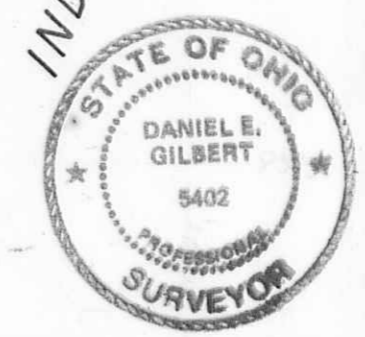

INDEXED ON MAP
6633

S-407