


N

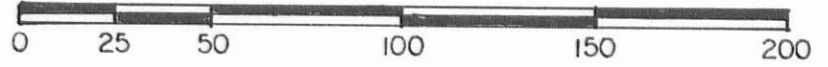

Scale: 1" = 50'

Reference:  
Mount Crest Acres Allotment No. 2,  
Plat Cab. A Side 533 (7-21-1971).

- Symbols:
- ⊙ - 1" Round Iron Bar Fd.
  - - 3/4" O. D. Iron Pipe Fd.
  - - R. R. Spike Set.
  - ⊗ - 5/8" Rebar Fd.
  - - 5/8" x 30" Rebar Set.



ReSurvey of Lot No. 108 - V.M.S. No. 3220,  
Mount Crest Acres Allotment No. 2,  
Jefferson Township, Logan County, Ohio.

SCALE: 1" = 50'	APPROVED BY:	DRAWN BY DEG
DATE: 3-25-1999		REVISED

*Daniel E. Gilbert, P.S.*  
Daniel E. Gilbert, P.S.  
Reg. Sur. No. 5402

DRAWING NUMBER  
099-008

INDEXED ON MAP  
3756

S-514