



ZANESFIELD ROAD - 60'
(U.S.R. No. 68)

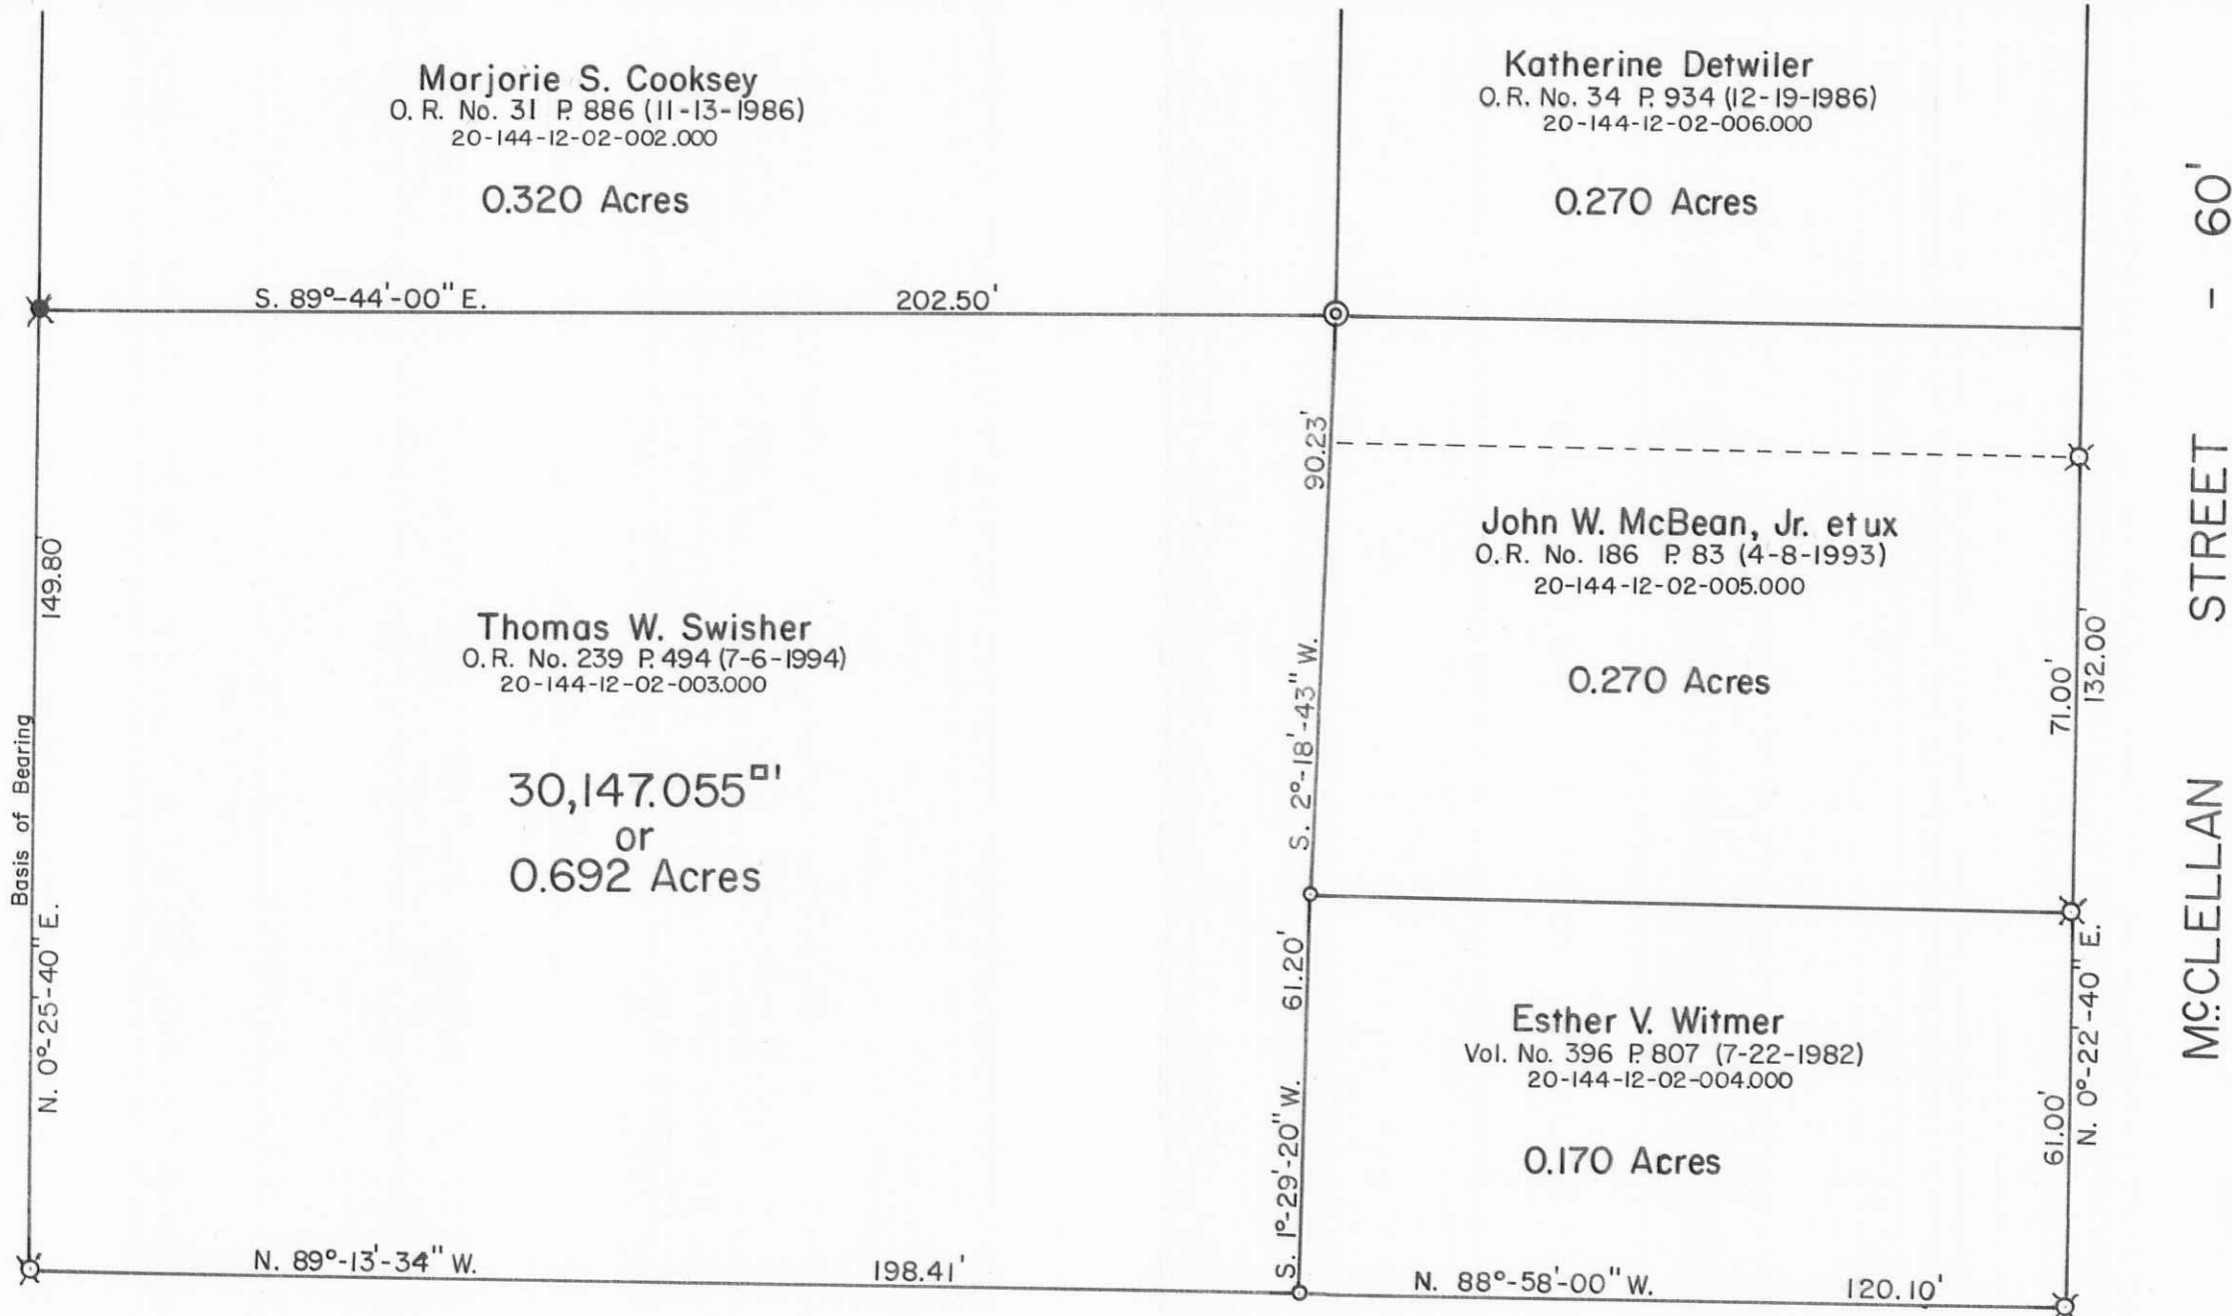

LEONARD STREET - 50'

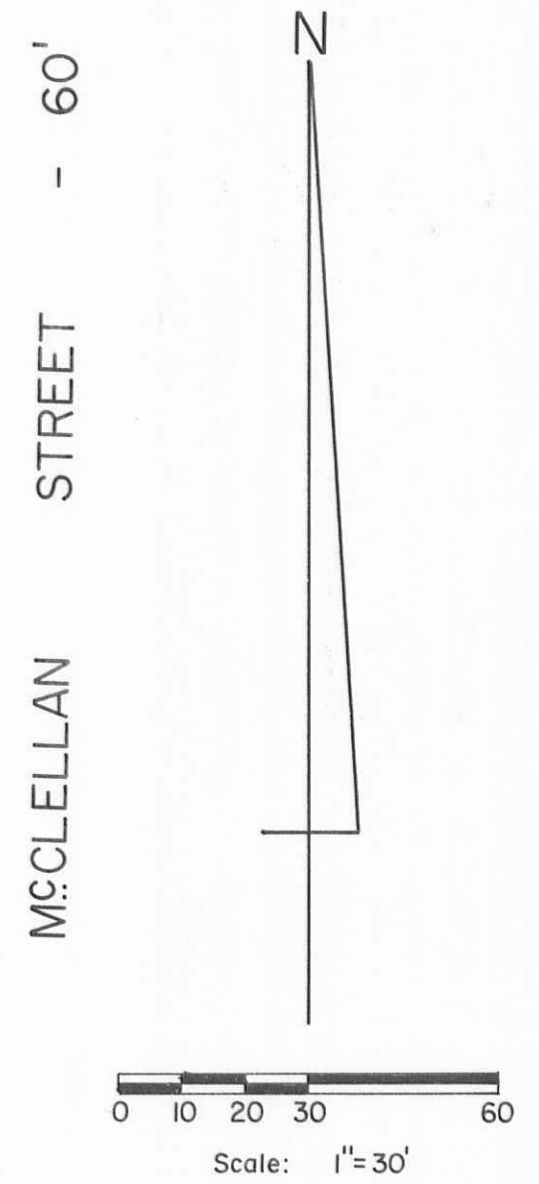

- SYMBOLS:
- - 1/2" Iron Pipes Fd.
 - ⊗ - 3/4" Iron Pipes Fd.
 - ⊙ - 2" Steel Axel Fd.
 - ★ - 5/8" x 30" Rebar Set in place of a bent 3/4" Iron Pipe Fd.

INDEXED ON MAP
2017



SWISHER SURVEY - Part of the North Half of
Section No. 27 T.5 R.13, B.M.R.S, Village of West Liberty,
Liberty Township, Logan County, Ohio.

SCALE: 1" = 30'	APPROVED BY:	DRAWN BY: DEG
DATE: 10-14-1994		REVISED:
<i>Daniel E. Gilbert</i> Daniel E. Gilbert, P.S. Reg. Sur. No. 5402		DRAWING NUMBER: 094-064

S-632