



E. BROWN AVE.

N. STANLEY ST.

S. 76°-00' W. 475.14' To Iron Bar Monument, Intersection Centerlines of Brown & Green

Robert H. Black et ux
 Vol. 407 P. 183 (10-26-1984)
 Per. Par. No. 17-092-09-14-018
 9,618.995^{sq} ft or 0.221 Acres

Robert J. Houchin et al
 O.R. No. 174 P. 63 (10-2-1992)
 Per. Par. No. 17-092-09-14-016
 14,143.29^{sq} ft or 0.325 Acres

Jack Johnston
 O.R. No. 161 P. 169 (6-23-1992)
 Per. Par. No. 17-092-09-14-017
 12,324.82^{sq} ft or 0.283 Acres
 330.83^{sq} ft or 0.008 Acres
 11,993.99^{sq} ft or 0.275 Acres

Lewis E. Smith
 Vol. 372 P. 195 (8-20-1977)
 Per. Par. No. 17-092-09-14-014
 Total
 9,765.63^{sq} ft or 0.224 Acres
 (4,392.145^{sq} ft or 0.101 Acres)

Jack Johnston
 O.R. No. 161 P. 169 (6-23-1992)
 Per. Par. No. 17-092-09-14-013
 3,826.985^{sq} ft or 0.088 Acres

Sherry A. Cooper
 O.R. No. 36 P. 862 (1-24-1986)
 Per. Par. No. 17-092-09-14-008
 0.40 Acres

John W. Godwin et ux
 Vol. 311 P. 347 (11-11-1966)
 Per. Par. No. 17-092-09-14-012
 0.14 Acres


Henry Ray Scott et ux
 Vol. 388 P. 93 (6-10-1980)
 Per. Par. No. 17-092-09-14-015
 0.46 Acres

Fred E. Harshfield et ux
 O.R. No. 53 P. 14 (11-7-1987)
 Per. Par. No. 17-092-09-14-019
 0.36 Acres

Note:
 Area of Encroachment revised.
 (6-11-1993) DEG.

● 5/8" x 30" Rebars Set.

Scale: 1" = 20'

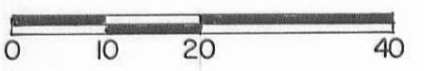

Reference:
 Mathew Whites Subdivision.
 Deed Vol. Q Pages 486-493.
 Logan County Recorders Office.

Surveyors Certification:
 I hereby certify to Citizens Federal Savings and Loan Association and that on June 11, 1993, I made an accurate survey of the premises shown hereon and that there are no easements or encroachments visible on the ground other than those shown hereon. This is a mortgage location survey prepared in accordance with Chapter 4733-58 of the Administrative Code. It is a boundary survey pursuant to Chapter 4733-37 of said code. This mortgage survey can be used by the property owner to establish property lines.

Daniel E. Gilbert
 DANIEL E. GILBERT, P.S.
 REG. SUR. NO. 5402
 400 N. PARK ST.
 BELLEFONTAINE, OHIO 43311
 TELEPHONE: 1 (513) 593-1428



Daniel E. Gilbert
 DANIEL E. GILBERT, P.S.
 Reg. Sur. No. 5402
 400 N. Park St.
 Bellefontaine, Ohio 43311

BLACK and JOHNSTON SURVEY
 Part of Lot No. 25 - Mathew Whites Subdivision
 Virginia Military Survey No. 4990
 City of Bellefontaine
 Lake Township
 Logan County, Ohio

August 29, 1989

S-656