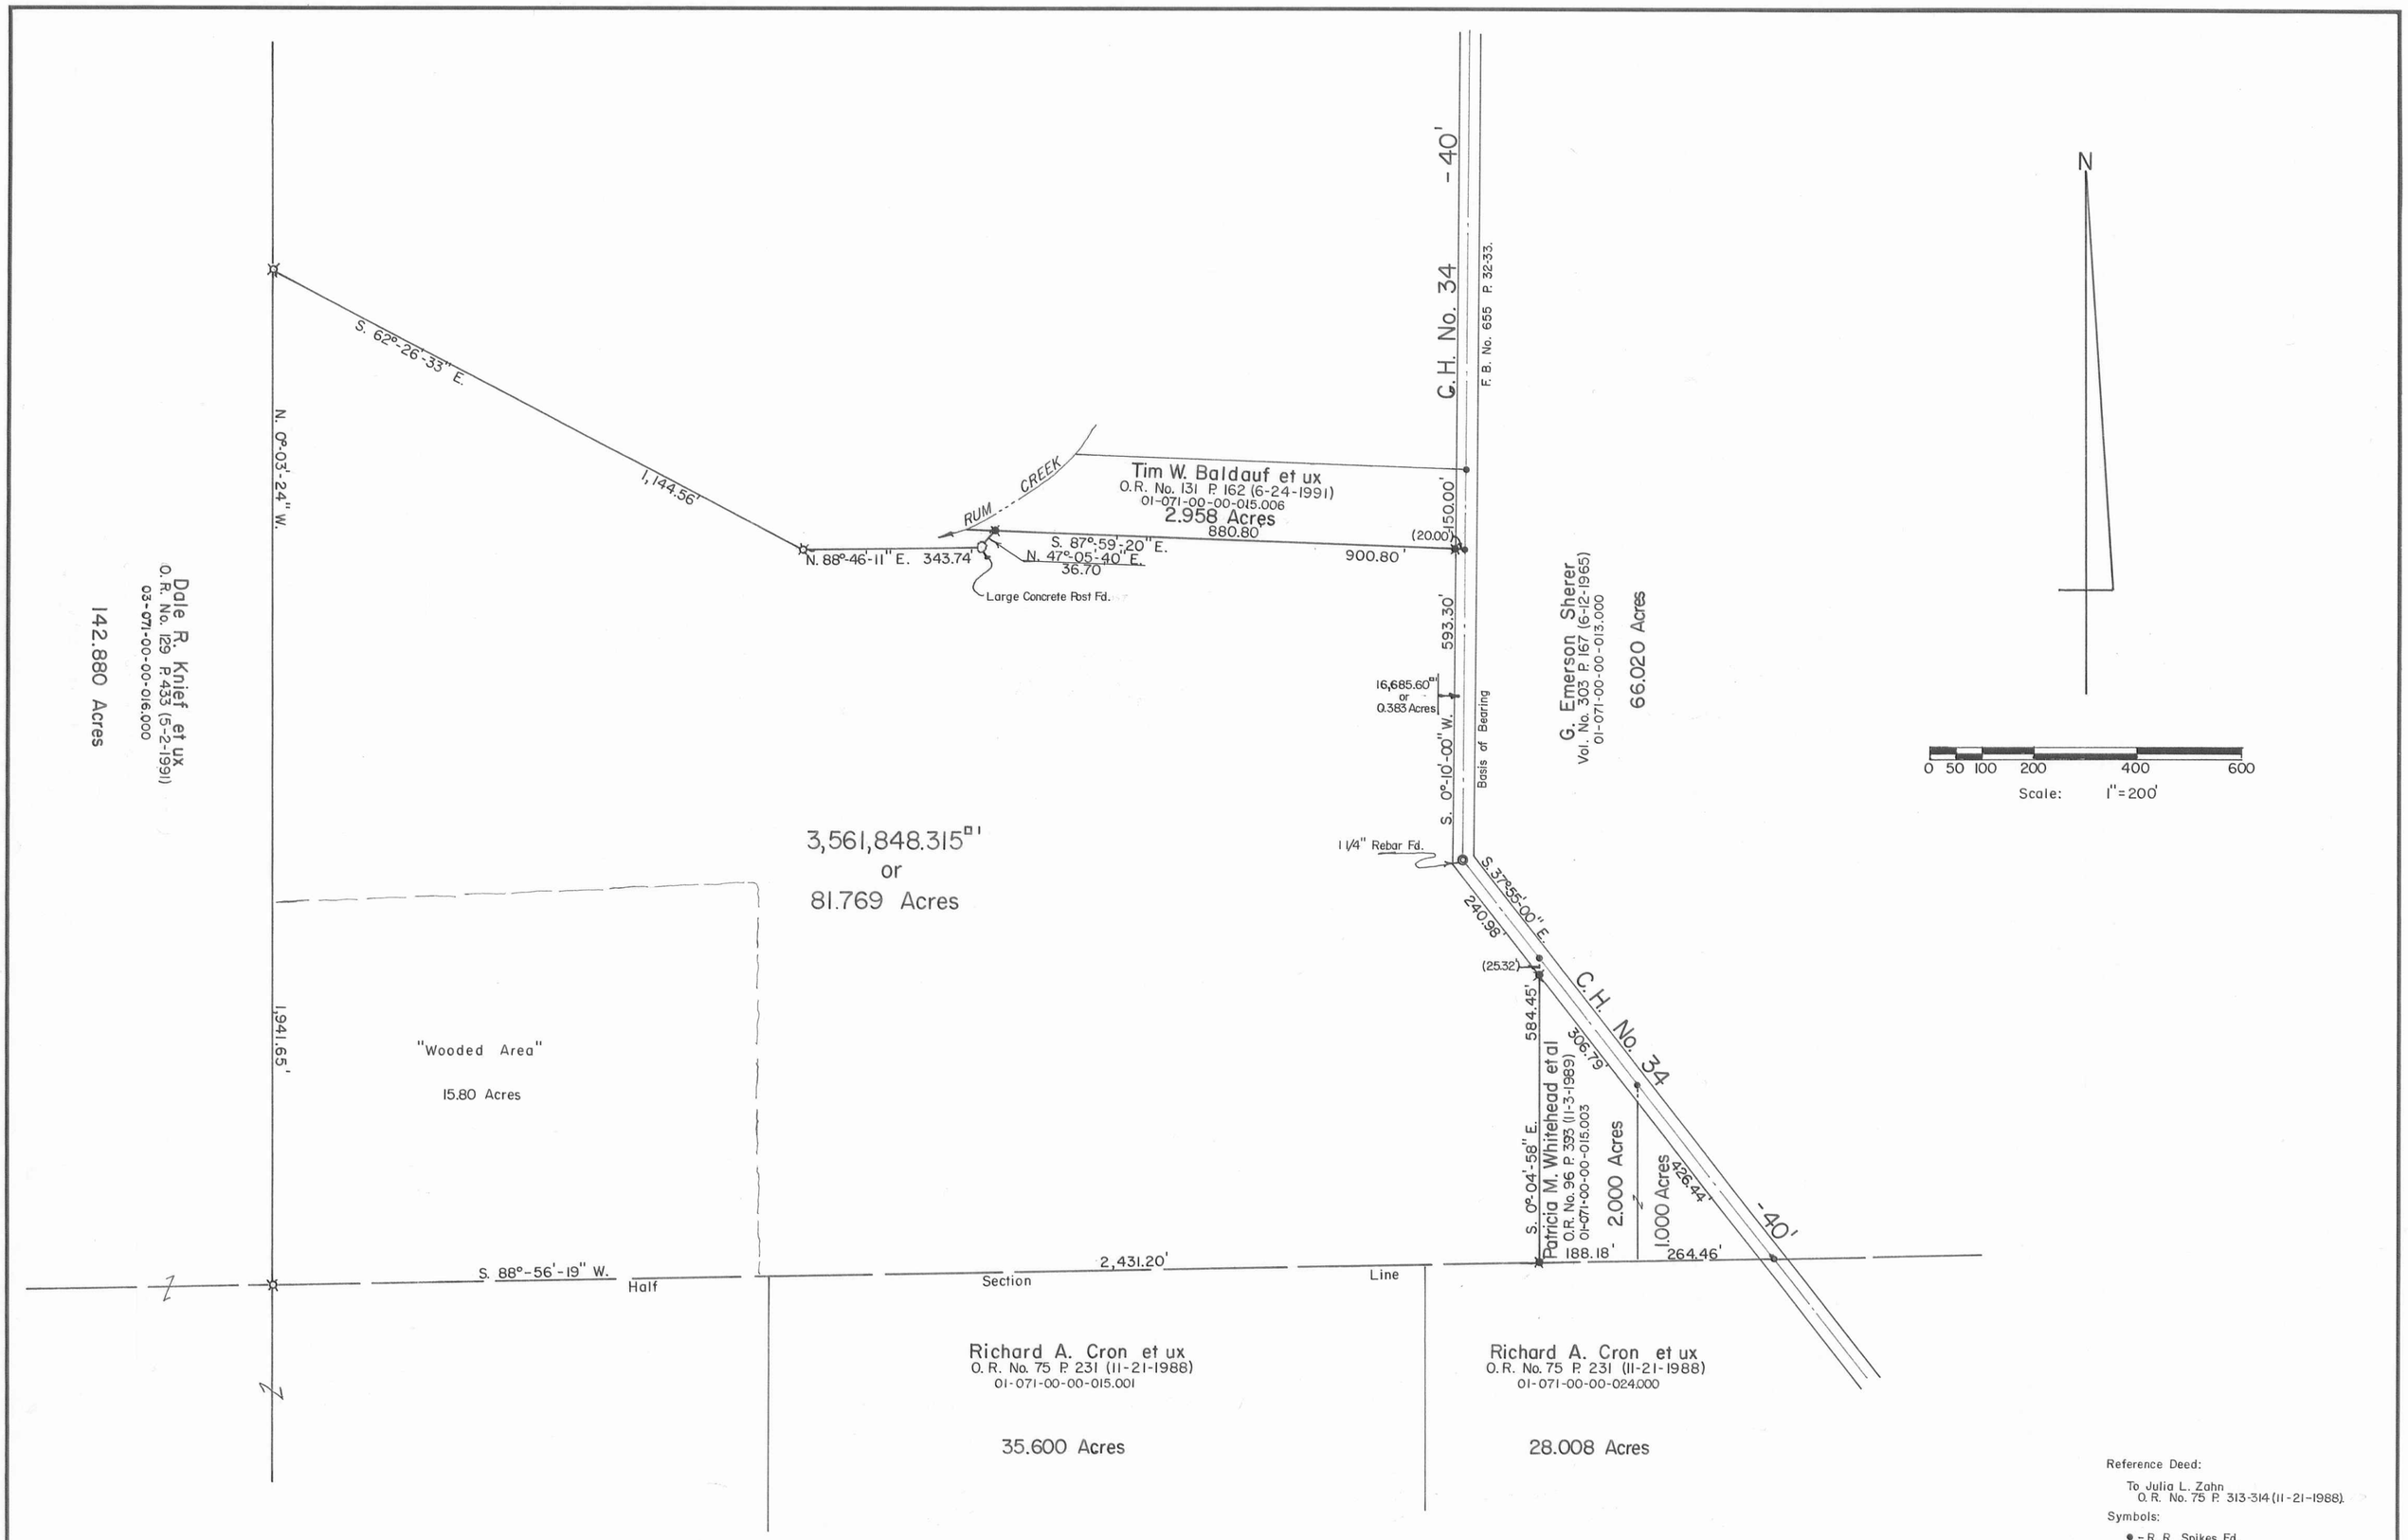

Reference Deed:

To Julia L. Zahn
O.R. No. 75 P. 313-314 (11-21-1988).

Symbols:

● - R. R. Spikes Fd.
⊠ - 5/8" Rebars Fd.
☆ - 5/8" x 30" Rebars Set.

STATE OF OHIO
DANIEL E. GILBERT
5402
PROFESSIONAL SURVEYOR

ZAHN SURVEY - Part of Per. Par. No. 01-071-00-00-015.000
Section No. 28 Town 2 Range 8,
Bloomfield Township, Logan County, Ohio.

SCALE: 1" = 200'	APPROVED BY	DRAWN BY DEG
DATE: 12-17-1993		

Daniel E. Gilbert

Daniel E. Gilbert, P.S.
Reg. Sur. No. 5402

DRAWING NUMBER
093-054

INDEXED ON MAP
1283

TELEDYNE POST 18AB-15

S-681