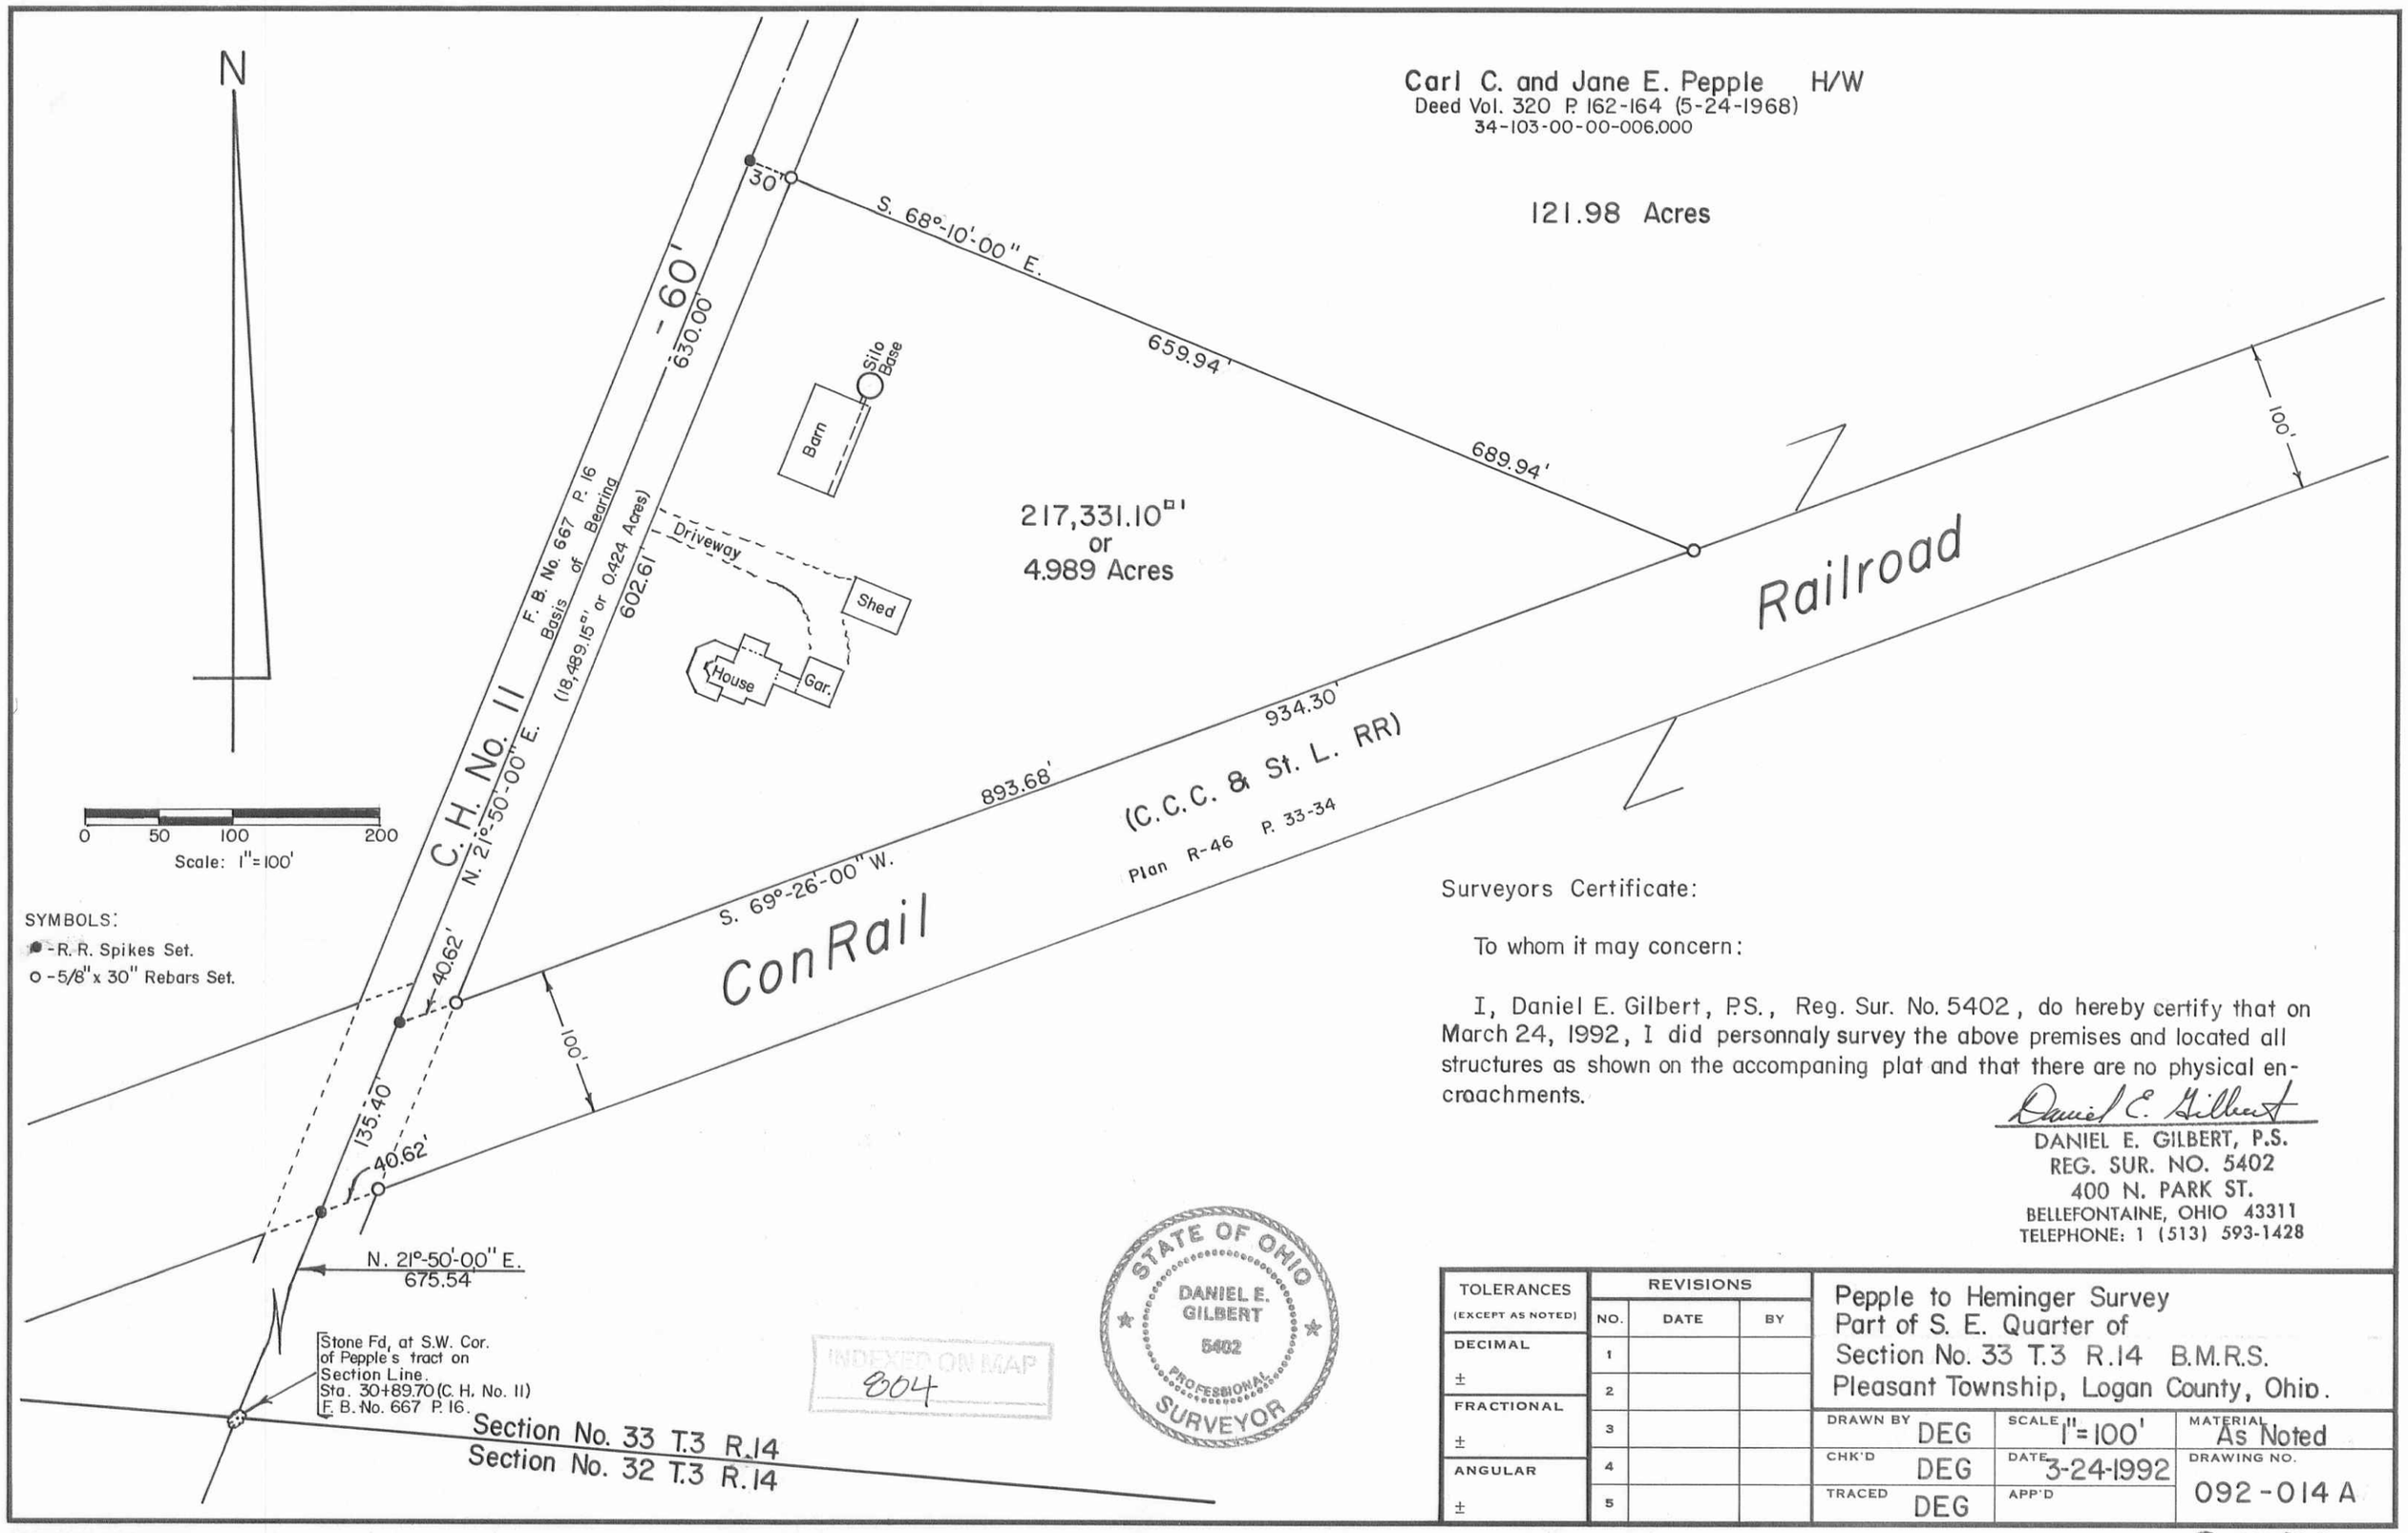

Surveyors Certificate:

To whom it may concern:

I, Daniel E. Gilbert, P.S., Reg. Sur. No. 5402, do hereby certify that on March 24, 1992, I did personnaly survey the above premises and located all structures as shown on the accompaning plat and that there are no physical encroachments.

Daniel E. Gilbert

DANIEL E. GILBERT, P.S.
REG. SUR. NO. 5402
400 N. PARK ST.
BELLEFONTAINE, OHIO 43311
TELEPHONE: 1 (513) 593-1428

TOLERANCES (EXCEPT AS NOTED)	REVISIONS			Pepple to Heminger Survey Part of S. E. Quarter of Section No. 33 T.3 R.14 B.M.R.S. Pleasant Township, Logan County, Ohio.		
DECIMAL ±	NO.	DATE	BY			
	1					
FRACTIONAL ±	2					
	3					
ANGULAR ±	4			DRAWN BY DEG	SCALE 1"=100'	MATERIAL As Noted
	5			CHK'D DEG	DATE 3-24-1992	DRAWING NO. 092-014 A
				TRACED DEG	APP'D	

TELEDYNE POST 18AE-08 -11X17

S-781