

N

Shirley Ann James
O. R. No. 50 P. 43 (9-17-1987)
37-019-00-00-011.000

54.060 Acres

Judith A. Jutras
Vol. No. 355 P. 454 (7-8-1974)
37-019-00-00-015.000


0.470 Acres

84,269.28^{sq}
or
1.935 Acres

T.R. No. 96

Reference:
John L. Baughman
O.R. No. 101 P. 88-92 (1-26-1990)

Symbols:
○ - 3/4" Iron Pipes Fd.
⊙ - 2" Iron Pipe Fd.
⊗ - Bridge Spike set in tree root.
⊕ - 3/4" Iron Bar Fd.
⊙ - 5/8" x 30' Rebars Set.
⊗ - 5/8" Iron Bars Fd.

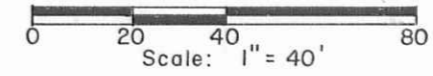


James E. Duff
O.R. No. 119 P. 565 (12-27-1990)
37-019-00-00-014.000

29.670 Acres

Resurvey of John L. Baughman's Property
V.M.S. No. 9968, Richland Township,
Logan County, Ohio.
Per. Par. No. 37-019-00-00 016.000

DRAWN BY	DEG	SCALE	1" = 40'	MATERIAL	As Noted
CHK'D	DEG	DATE	6-26-1992	DRAWING NO.	092-037
TRACED	DEG	APP'D			

TOLERANCES (EXCEPT AS NOTED)	REVISIONS		
	NO.	DATE	BY
DECIMAL	1		
±	2		
FRACTIONAL	3		
±	4		
ANGULAR	5		
±			

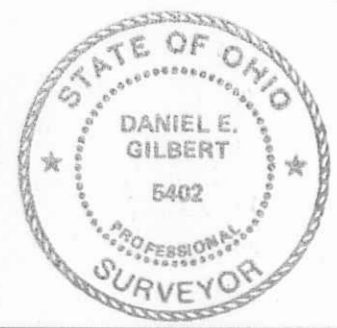

Daniel E. Gilbert
DANIEL E. GILBERT, P.S.
REG. SUR. NO. 5402
400 N. PARK ST.
BELLEFONTAINE, OHIO 43311
TELEPHONE: 1 (513) 593-1428

INDEXED ON MAP
3955

S-818