



# INDIAN LAKE

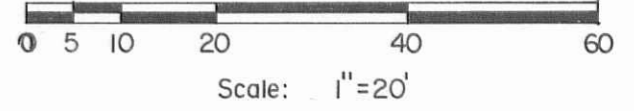

- Reference Deeds:**
- Don Shuler et al  
43-019-09-01-013.001 - 0.0011 Acres.  
O.R. No. 245 P 2 (11-7-1994).
  - Don Shuler et al  
43-019-09-01-013.002 - 0.0014 Acres.  
O.R. No. 245 P 4 (11-7-1994).
- Symbols:**
- - 1/2" Iron Pipes Fd.
  - ⊗ - 5/8" x 30" Rebars Fd.
  - ⊙ - 5/8" x 30" Rebars Set.

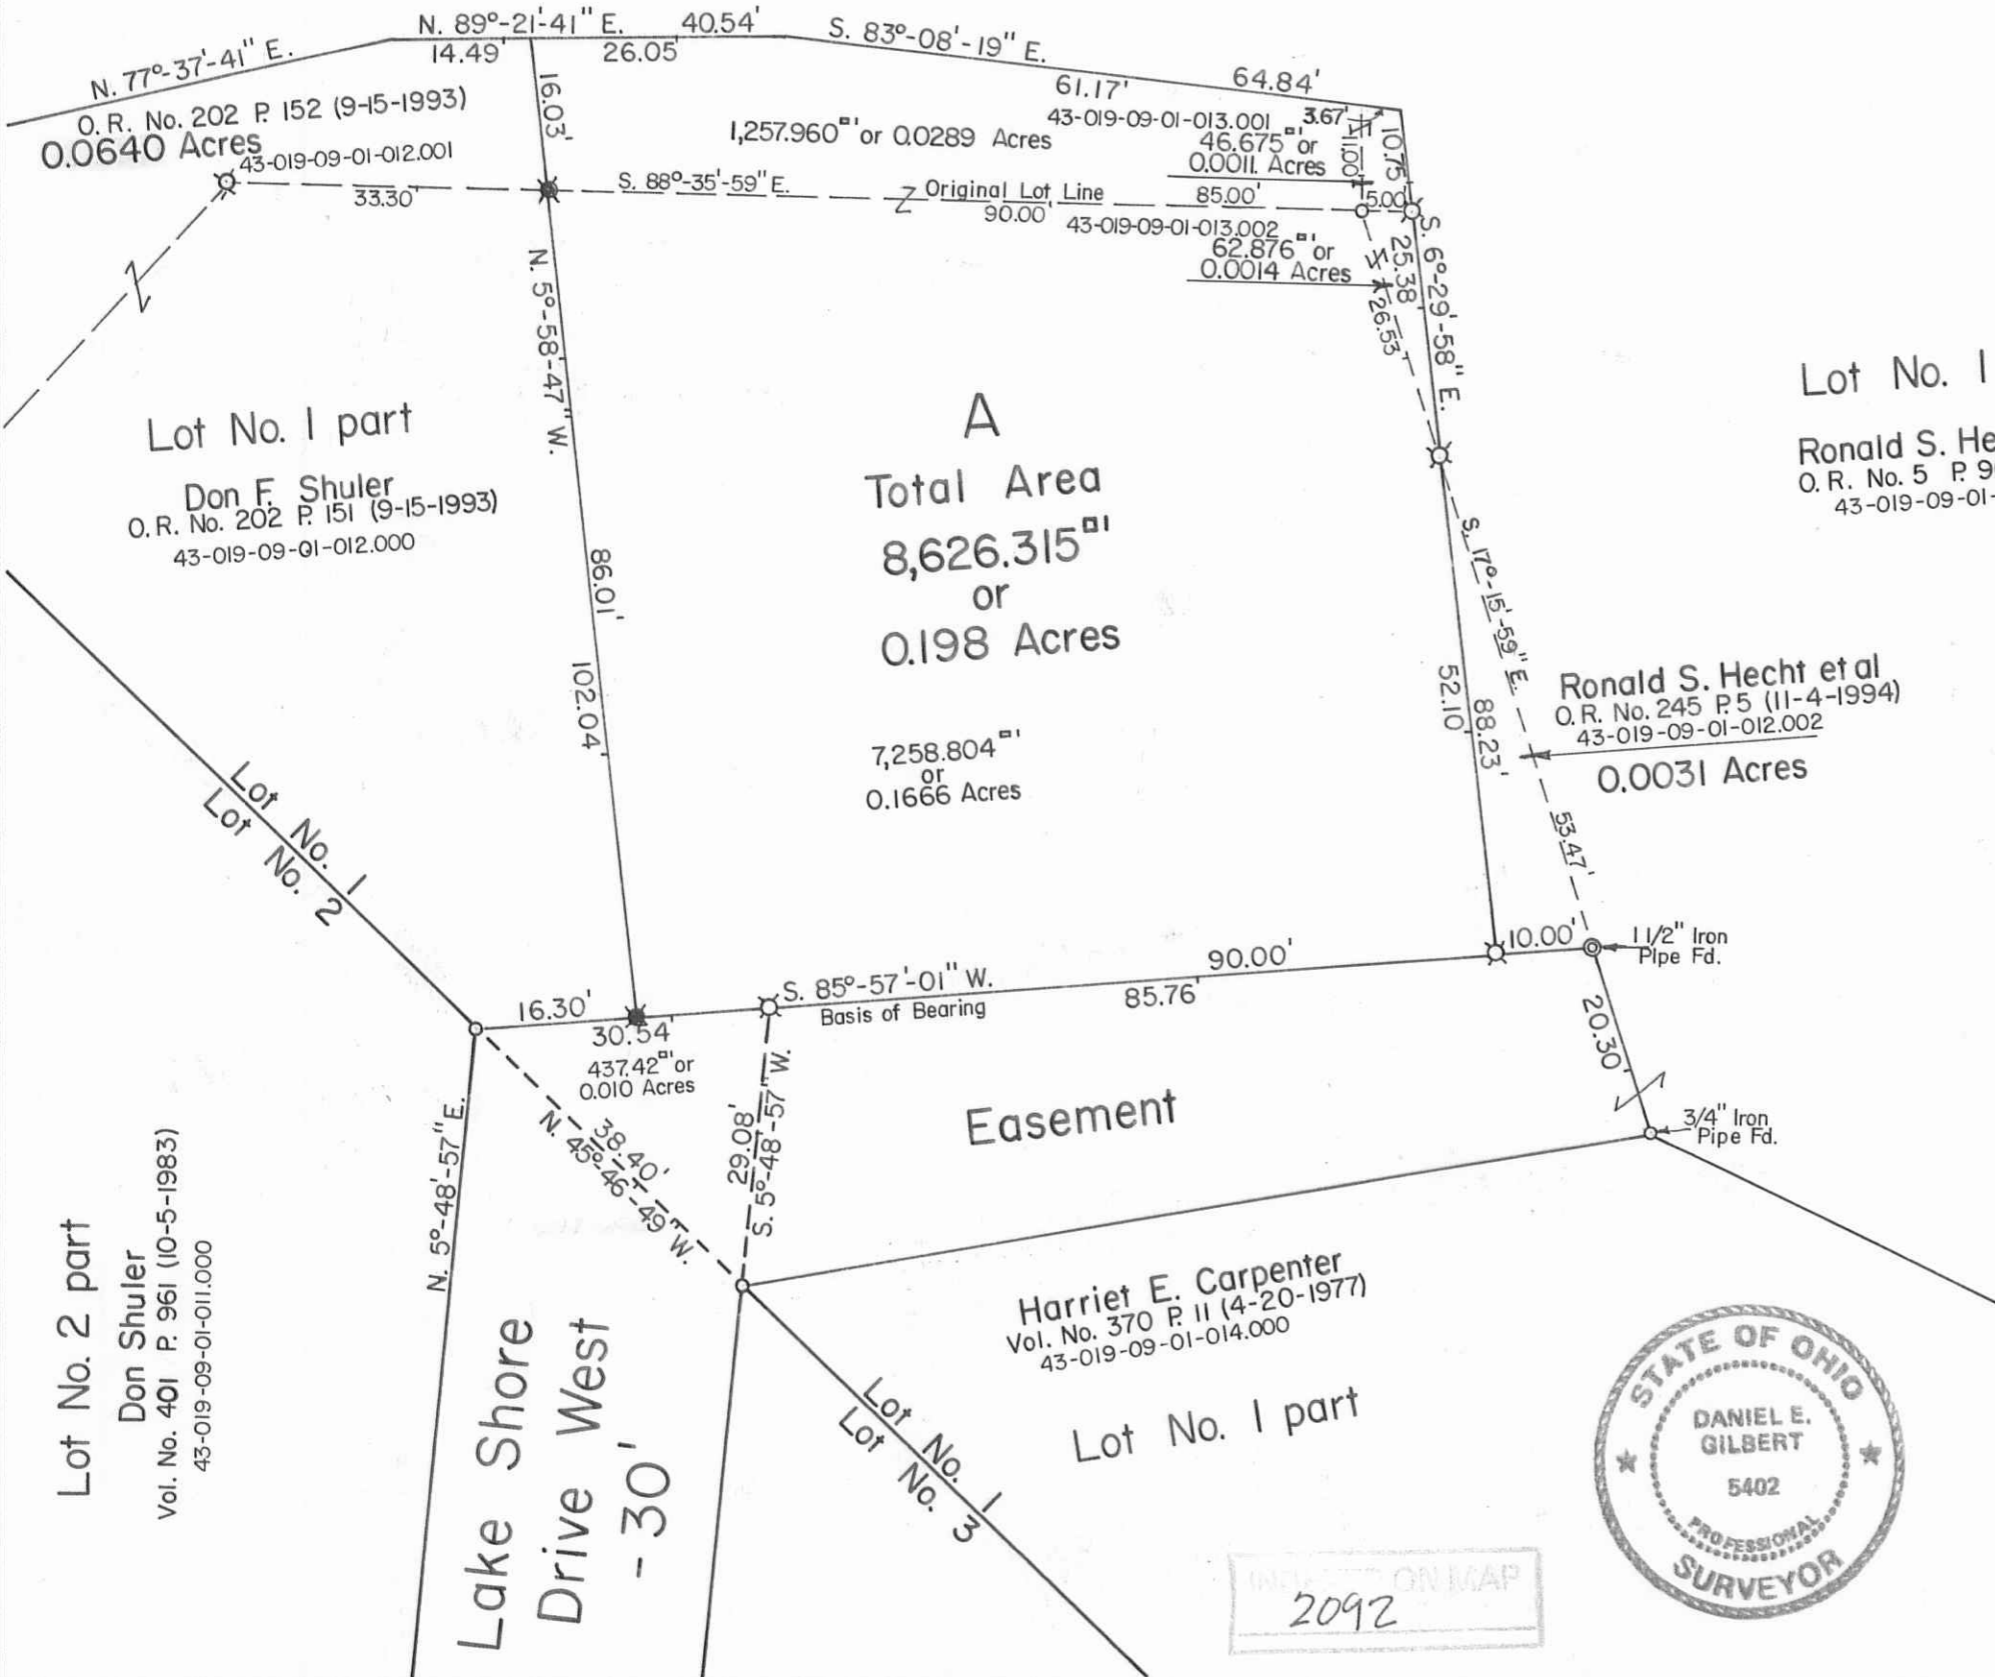

**Don F. Shuler Survey - Part of Lot No. 1, V.M.S. No. 12276, Shawnee Island Allotment, Shawnee Island, Stokes Township, Logan County, Ohio.**

SCALE: 1" = 20'	APPROVED BY:	DRAWN BY: DEG
DATE: 10-4-1995		REVISED:
<i>Daniel E. Gilbert</i> Daniel E. Gilbert, P.S. Reg. Sur. No. 5402		DRAWING NUMBER: 095-048

INDEX ON MAP  
2092

S-032