


SEE SHEET 6

SEE SHEET 7

SEE SHEET 16

15

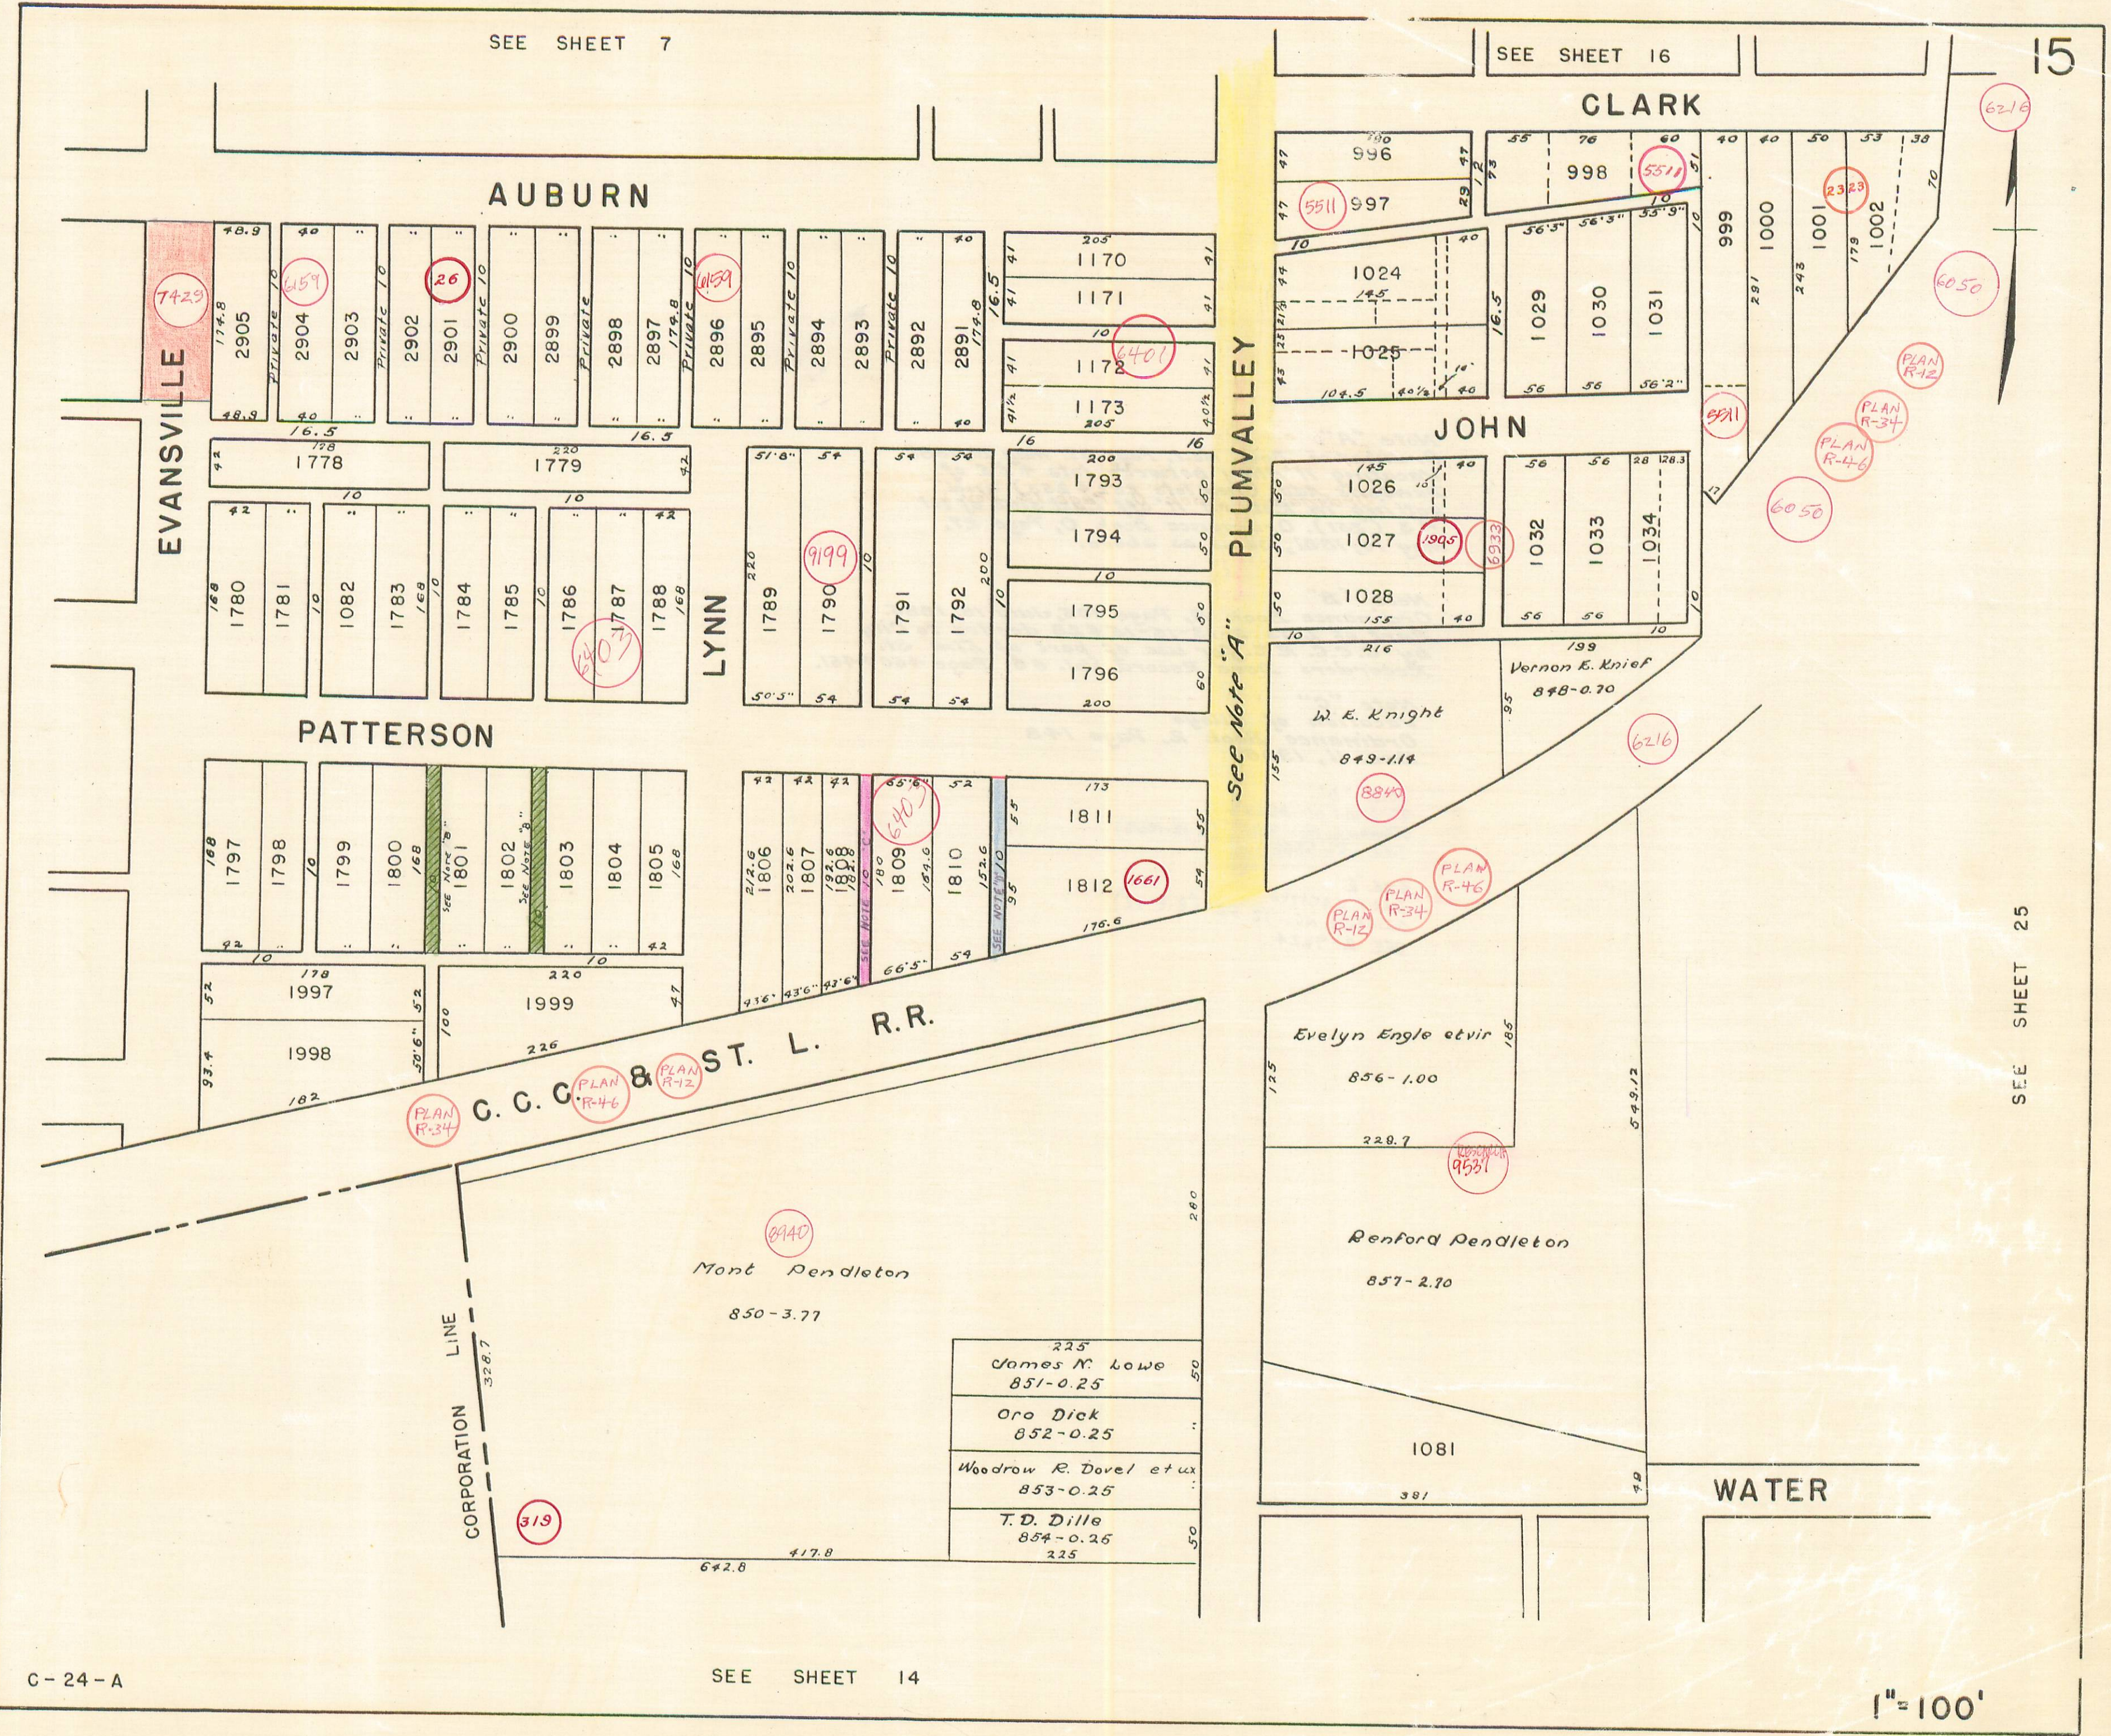

C-24-A

SEE SHEET 14

SEE SHEET 25

1" = 100'