


see Lake Twp. Page 2

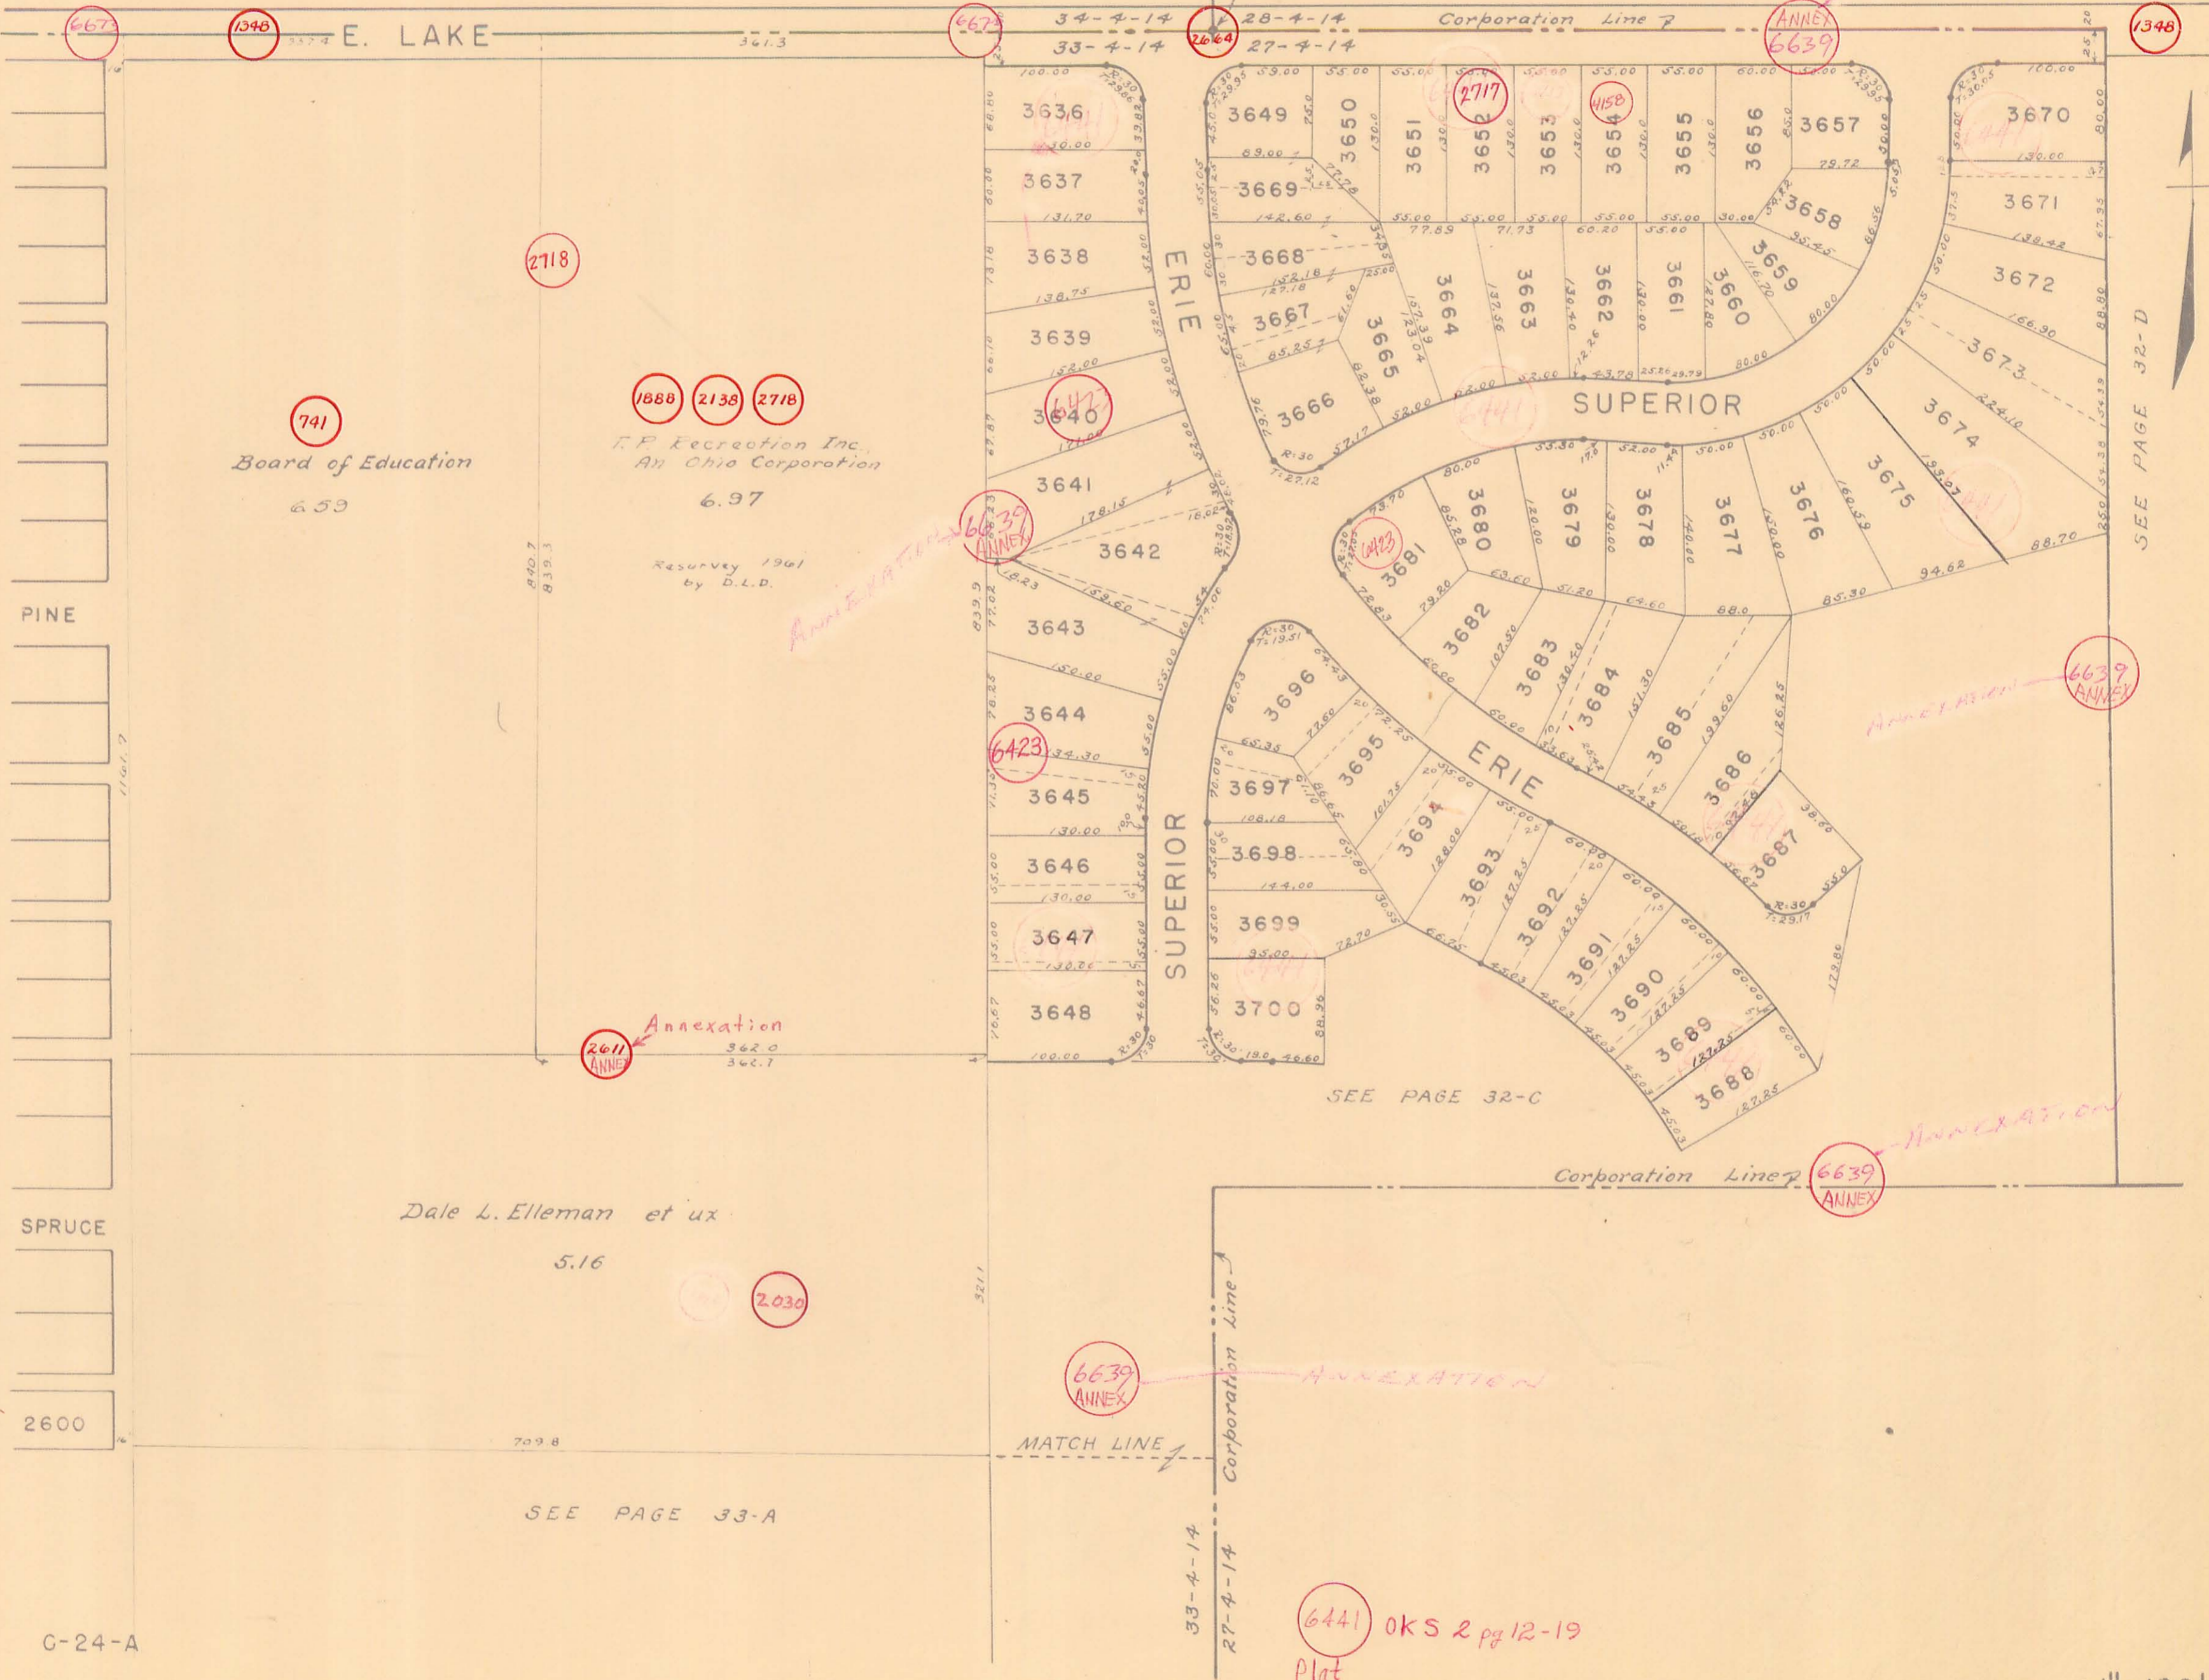

667
1348
2718
741
Board of Education
659
PINE
1701.7
SPRUCE
2600

Board of Education
659

1888 2138 2718
F.P. Recreation Inc.
An Ohio Corporation
6.97
Resurvey 1961
by D.L.D.

Dale L. Elleman et ux
5.16

SEE PAGE 33-A

C-24-A

SECTION CORNER

34-4-14 28-4-14
33-4-14 27-4-14

Corporation Line 7

ERIE

SUPERIOR

SUPERIOR

ERIE

Corporation Line 7

MATCH LINE

33-4-14
27-4-14
Corporation Line

SEE PAGE 32-D

SEE PAGE 32-C

6441 OKS 2 pg 12-19
Plat
Lake Heights Allot. No. 1

1" = 100'