


SEE SHEET 47

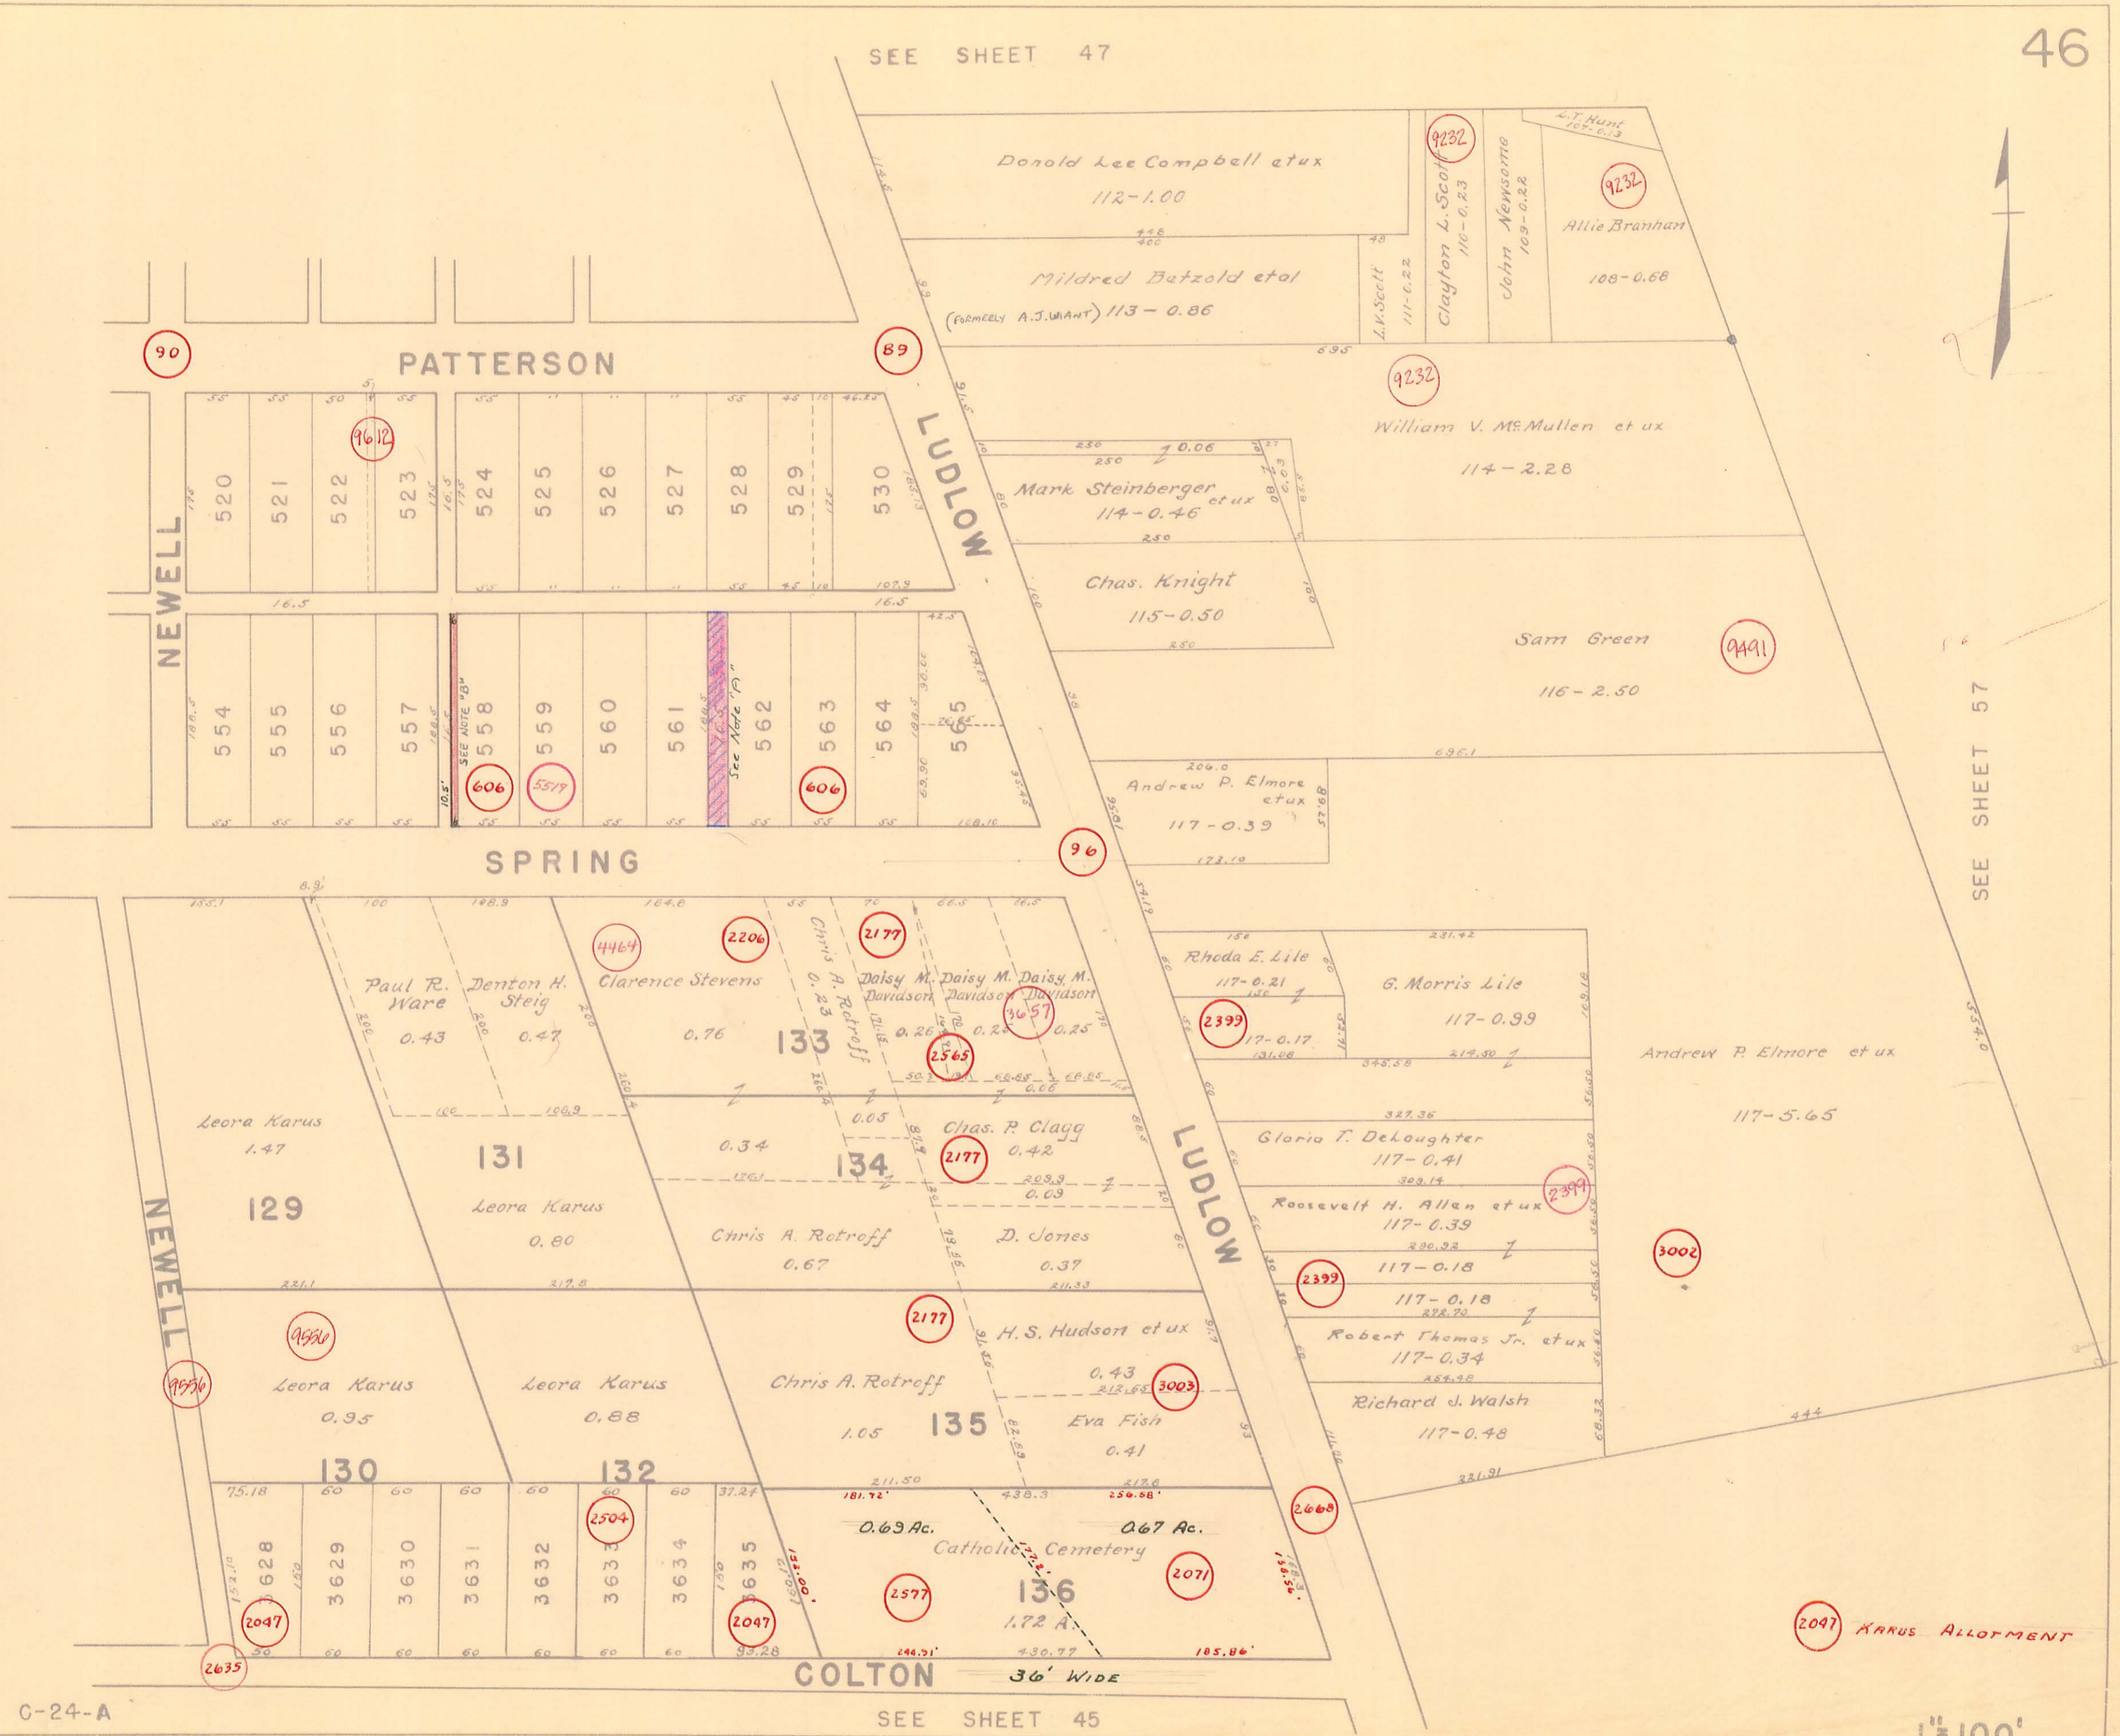

SEE SHEET 57



C-24-A

SEE SHEET 45

1"=100'